

DELANCEY STREET

ELDRIDGE STREET

SEC. 2 BLOCK 415

STANTON STREET

SEC. 2 BLOCK 416

SEC. 2 BLOCK 417

EAST HOUSTON STREET

SEC. 2 BLOCK 442

FIRST AVENUE

ALLEN STREET

SEC. 2 BLOCK 415

ALLEN STREET

SEC. 2 BLOCK 416

SEC. 2 BLOCK 417

FIRST AVENUE

SEC. 2 BLOCK 428

STREET


ORCHARD STREET

ORCHARD STREET

ORCHARD STREET

FILED

NOTE: Original tracing of this map look. Photostat made from print in B. of E. ak.

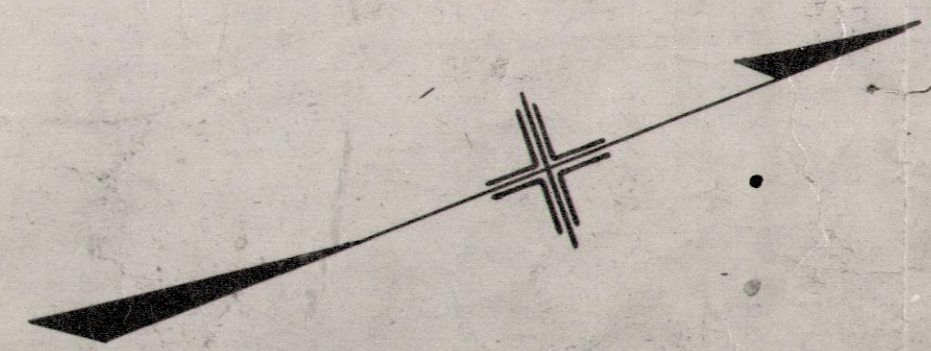

Approved by Bd. of Est. on April 22/26, Cal. No. 2, Approved by the Mayor on May 24/26.

FILED

CITY OF NEW YORK BOROUGH OF MANHATTAN OFFICE OF THE PRESIDENT DEPARTMENT OF PUBLIC WORKS BUREAU OF ENGINEERING MAP SHOWING A CHANGE IN THE STREET SYSTEM HERETOFORE LAID OUT WITHIN THE TERRITORY BOUNDED BY DELANCEY ST., ELDRIDGE ST., FIRST ST. AND ORCHARD ST. BY WIDENING ALLEN STREET BETWEEN DELANCEY STREET AND EAST HOUSTON STREET FIRST AVENUE BETWEEN EAST HOUSTON STREET AND FIRST STREET

LEGEND LINES PREVIOUSLY LAID OUT AND RETAINED ARE SHOWN BY FULL BLACK LINES LINES AND DIMENSIONS HEREBY ESTABLISHED ARE SHOWN BY FULL RED LINES AND RED FIGURES. LINES HEREBY DISCONTINUED ARE SHOWN BY DASH RED LINES.

DATED APR. 1-1926 SCALE 1" = 80'

DRAWN BY W.W. CHECKED BY O.C.M.

A. J. Peck ASSISTANT ENGINEER

J. C. Callahan ENGINEER OF DESIGN

Chief Engineer

Pres. Boro. of Manhattan

17x26 ACC 25592