

LEGEND
 LINES AND DIMENSIONS PREVIOUSLY LAID OUT AND HEREBY RETAINED ARE SHOWN BY FULL BLACK LINES AND BLACK FIGURES.
 LINES AND DIMENSIONS HEREBY ESTABLISHED ARE SHOWN BY FULL RED LINES AND RED FIGURES.
 LINES HEREBY DISCONTINUED ARE SHOWN BY DASHED RED LINES.



I, PETER J. MCGOWAN, SECRETARY OF THE BOARD OF ESTIMATE AND APPORTIONMENT OF THE CITY OF NEW YORK, DO HEREBY CERTIFY THAT THIS MAP IS ONE OF THREE SIMILAR MAPS MADE AT THE DIRECTION OF, AND ADOPTED BY, THE SAID BOARD OF ESTIMATE AND APPORTIONMENT ON THE 15TH DAY OF NOVEMBER 1928, AND APPROVED BY THE MAYOR ON THE 21ST DAY OF NOVEMBER 1928 SUPERSEDING ALL MAPS HERETOFORE FILED AFFECTING THE AREA EMBRACED BY SAID MAP IN SO FAR AS IT MAKES ANY CHANGES THEREIN.
 PREPARED FOR THE BOARD OF ESTIMATE AND APPORTIONMENT UNDER AUTHORITY OF THE CHARTER OF THE CITY OF NEW YORK.
 DATED, NEW YORK, FEB. 20 1929
Peter J. McGowan
 SECRETARY,
 BOARD OF ESTIMATE AND APPORTIONMENT

DRAWN BY L. N. ADLER.
 CHECKED BY A. V. F.

L. N. Adler
 SECTION ENGINEER

J. C. Collyer
 ENGINEER OF DESIGN.

Drawn 11

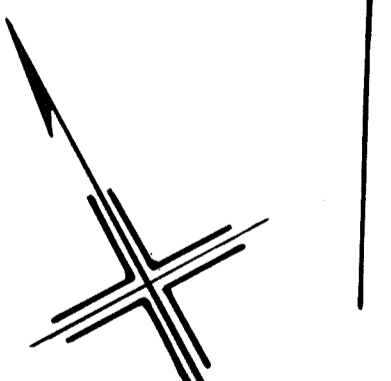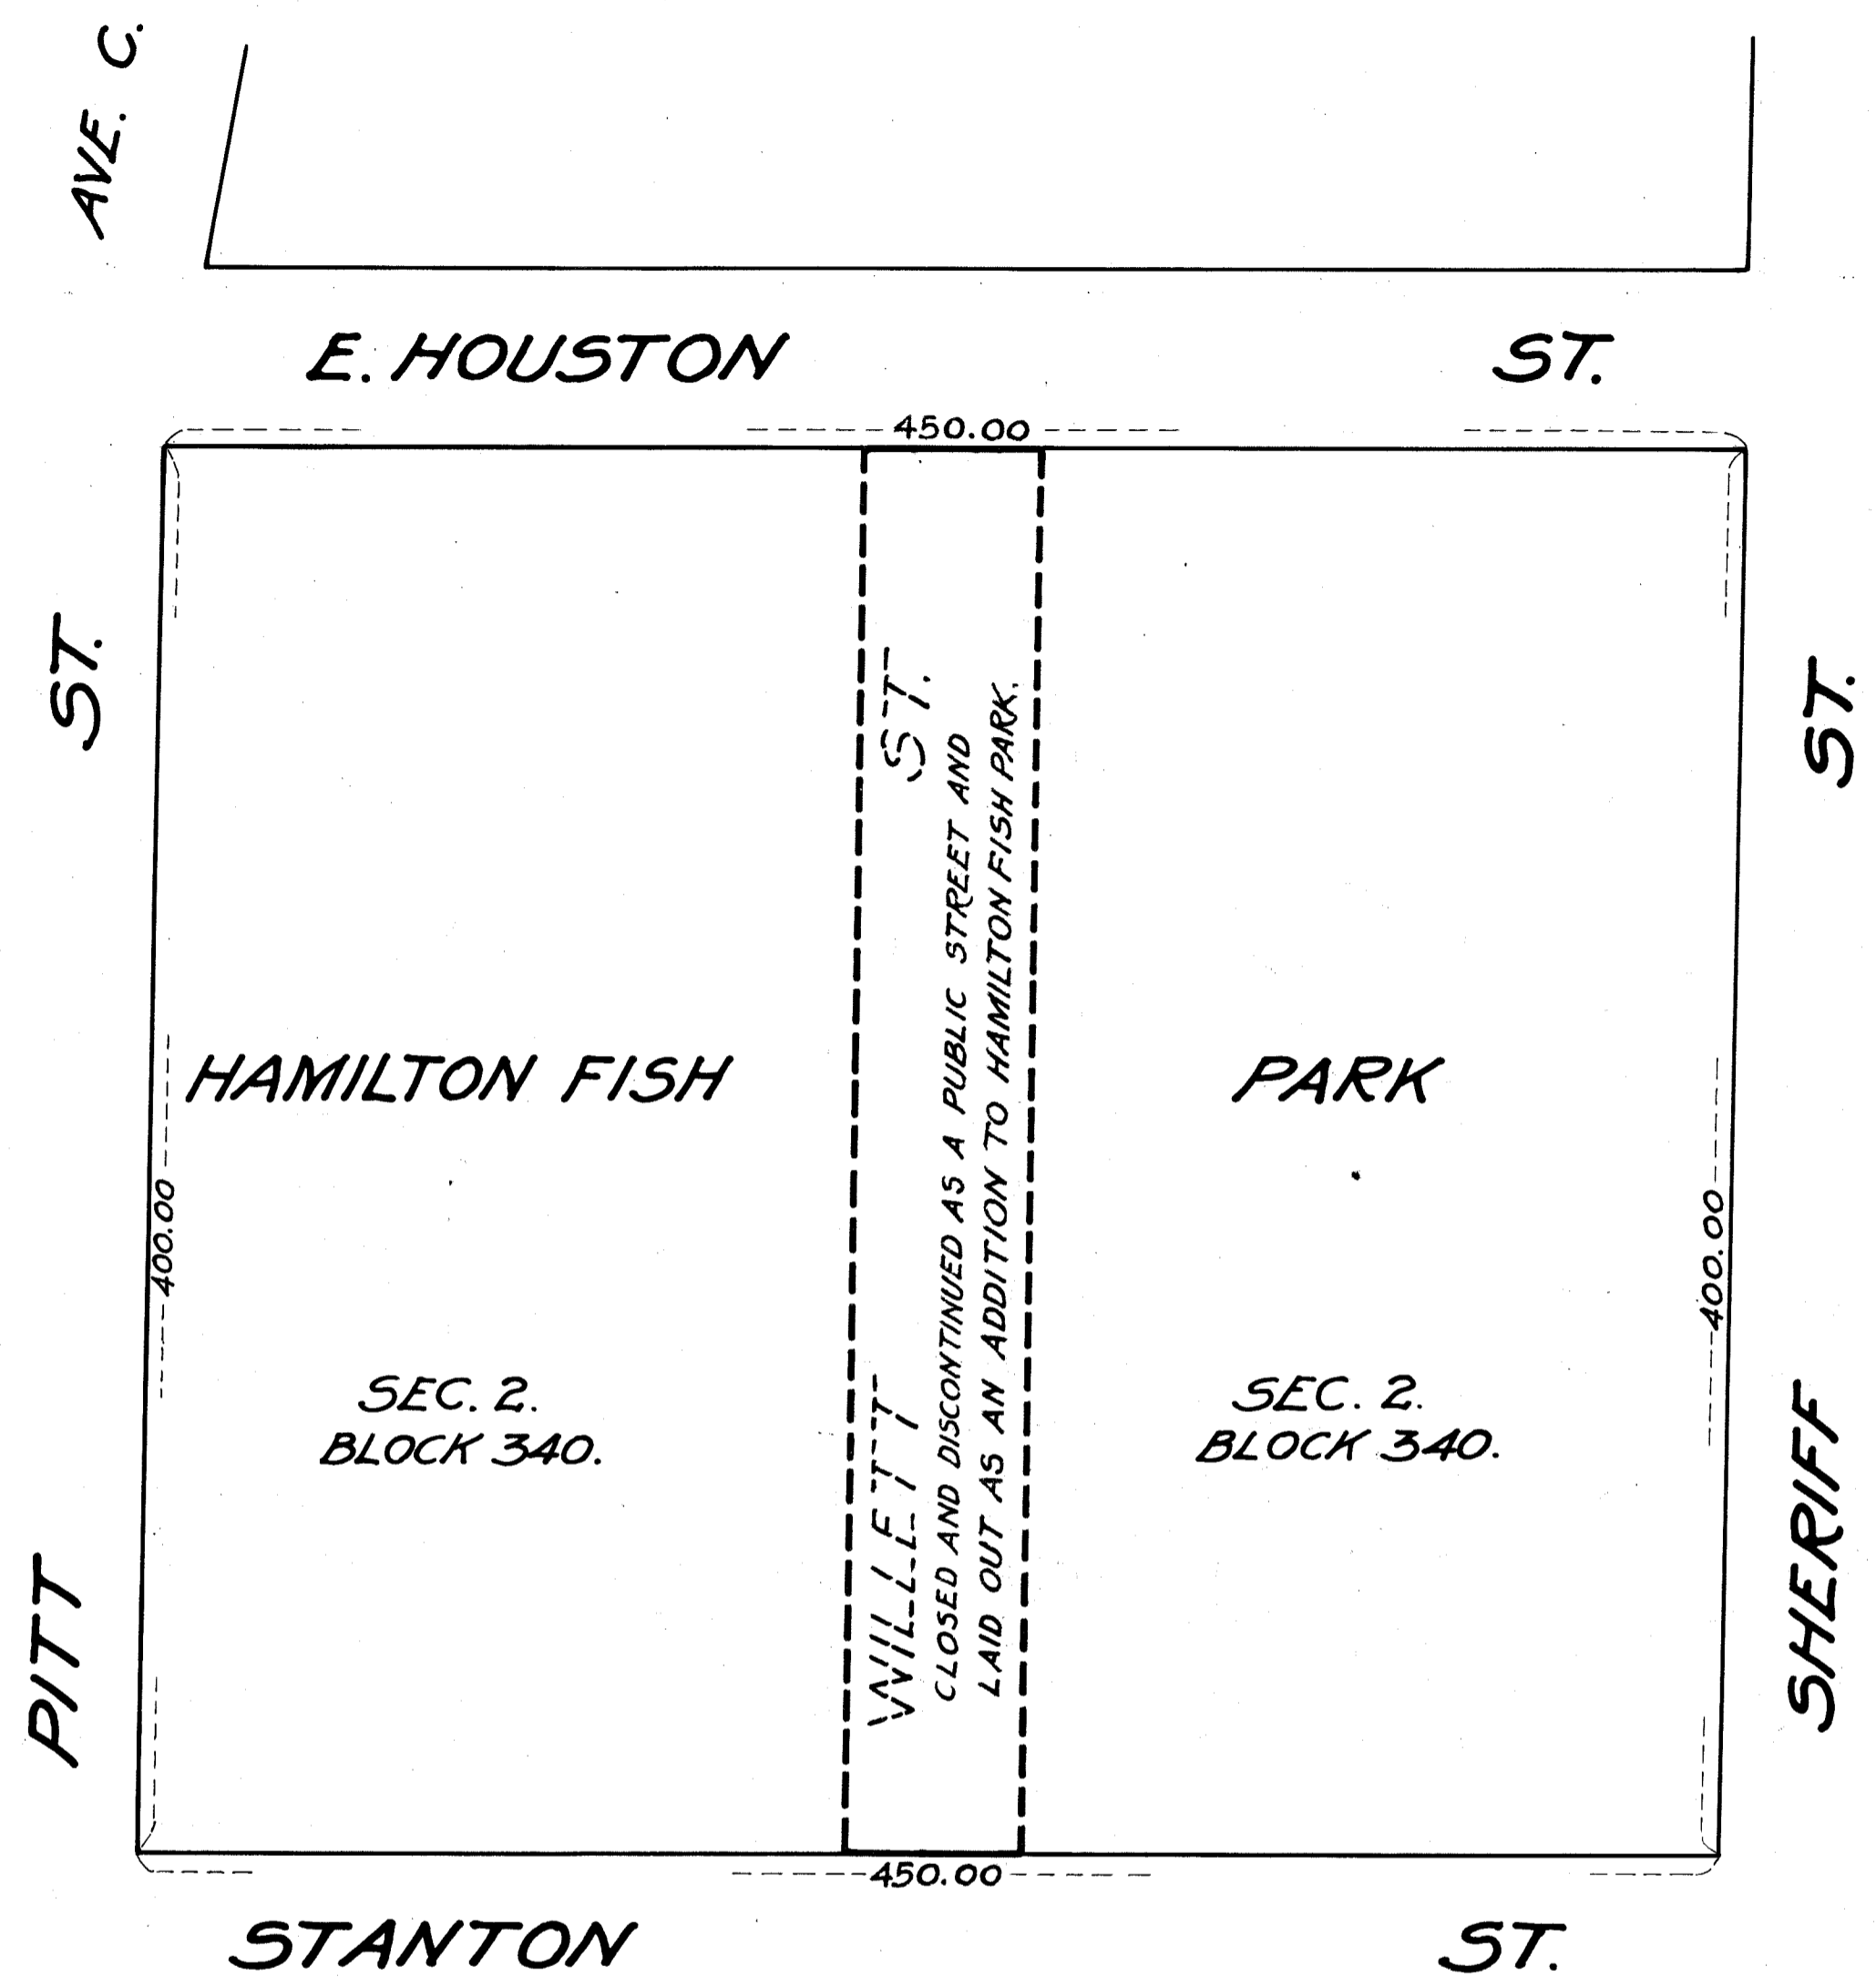

CITY OF NEW YORK BOROUGH OF MANHATTAN
 OFFICE OF THE PRESIDENT
 DEPARTMENT OF PUBLIC WORKS
 BUREAU OF ENGINEERING

**MAP SHOWING
 A CHANGE IN THE STREET AND PARK SYSTEM
 HERETOFORE LAID OUT WITHIN THE TERRITORY
 BOUNDED BY STANTON ST. PITT ST. EAST
 HOUSTON ST. AND SHERIFF ST. BY
 CLOSING AND DISCONTINUING
 WILLETT STREET
 BETWEEN STANTON ST. AND E. HOUSTON ST.
 AND
 LAYING OUT
 AN ADDITION TO HAMILTON FISH PARK
 DATED MAY 22, 1928. SCALE: 1"=50'**

Charles E. Peterson
 CHIEF ENGINEER

J. Lewis Miller
 PRES. BORO. OF MANHATTAN

Filed in Office of Borough Clerk
 Manhattan 3/2/29

FILE No. 73.21 Acc. No. 26101