


AMSTERDAM AVE.

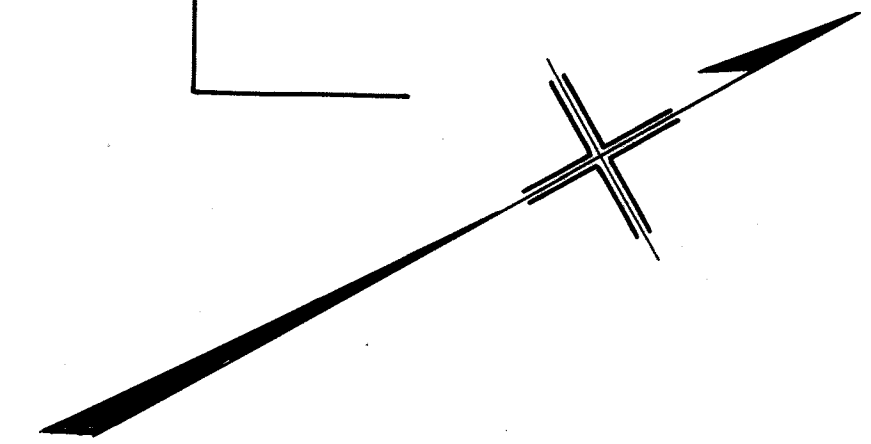

To N.B.L. W. 185<sup>TH</sup> ST. 214.83


I, Pearl Bernstein, SECRETARY OF THE BOARD OF ESTIMATE AND APPORTIONMENT OF THE CITY OF NEW YORK DO HEREBY CERTIFY THAT THIS MAP IS ONE OF THREE SIMILAR MAPS MADE AT THE DIRECTION OF, AND ADOPTED BY THE SAID BOARD OF ESTIMATE AND APPORTIONMENT ON THE 14<sup>TH</sup> DAY OF December, 1936, AND APPROVED BY THE MAYOR ON THE 11<sup>TH</sup> DAY OF December, 1936. SUPERSEDING ALL MAPS HERETOFORE FILED AFFECTING THE AREA EMBRACED BY SAID MAP IN SO FAR AS IT MAKES ANY CHANGES THEREIN.

PREPARED FOR THE BOARD OF ESTIMATE AND APPORTIONMENT UNDER AUTHORITY OF THE CHARTER OF THE CITY OF NEW YORK. DATED, NEW YORK, Dec. 15, 1936.

Pearl Bernstein  
SECRETARY  
BOARD OF ESTIMATE AND APPORTIONMENT


To P.C. R = 390.00  
X = 11-08-00  
L = 75.78

W. 186<sup>TH</sup> ST.

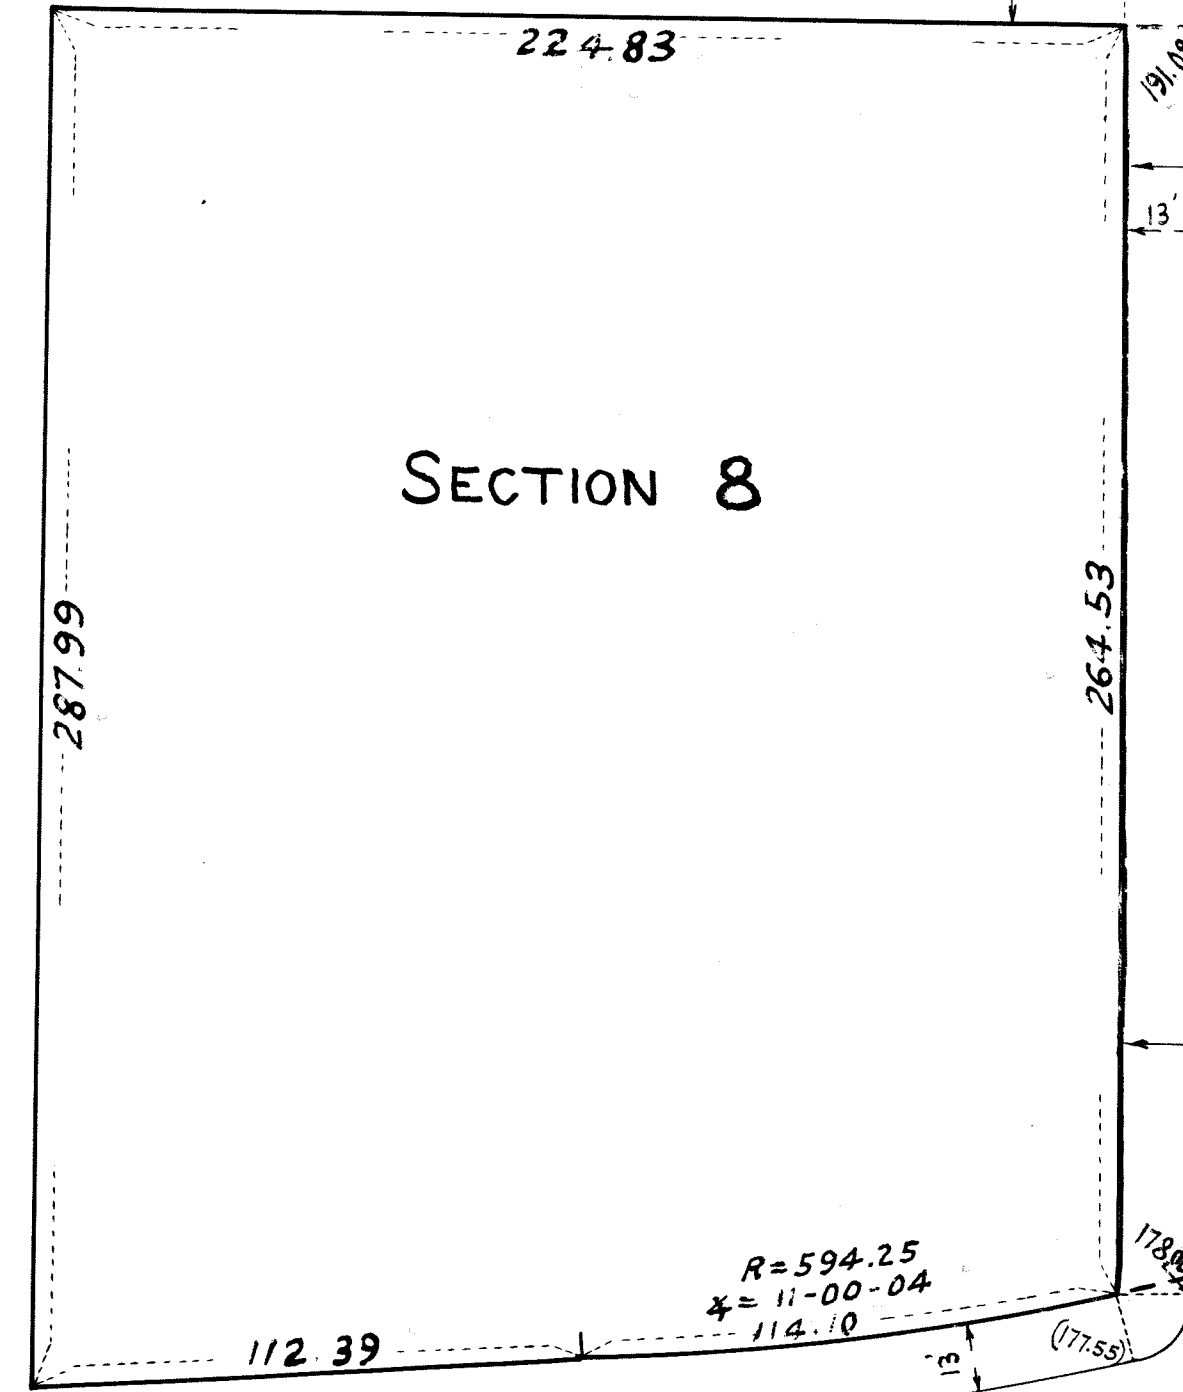

SECTION 8

W. 187<sup>TH</sup> ST.

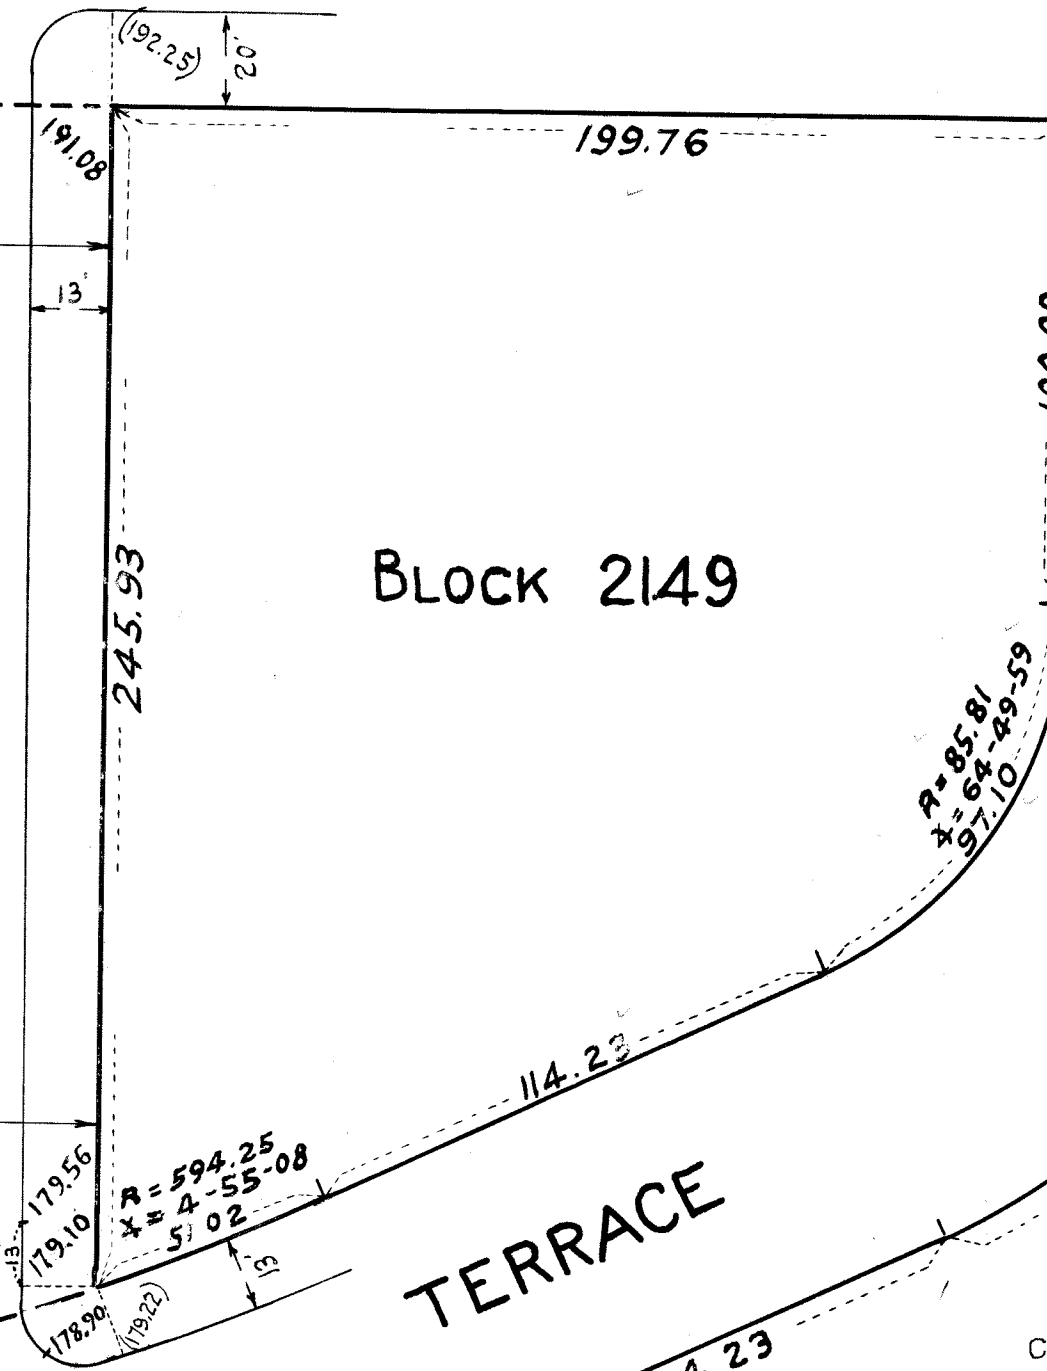

BLOCK 2149

TERRACE

LAUREL HILL

-LEGEND-

LINES AND DIMENSIONS HEREBY ESTABLISHED ARE SHOWN BY FULL RED LINES AND RED FIGURES.  
LINES AND DIMENSIONS PREVIOUSLY ESTABLISHED AND HEREBY RETAINED ARE SHOWN BY FULL BLACK LINES AND BLACK FIGURES.  
LINES HEREBY DISCONTINUED ARE SHOWN BY DASH RED LINES.  
GRADES HEREBY ESTABLISHED ARE SHOWN BY VERTICAL RED FIGURES.  
EXISTING SURFACE ELEVATIONS ARE SHOWN BY VERTICAL BLACK FIGURES ENCLOSED IN A PARENTHESIS AND WHERE HEREBY DISCONTINUED ARE CROSSED BY A BLACK LINE.  
ELEVATIONS ON THIS MAP ARE REFERRED TO THE PUBLIC WORKS DATUM OF THE BOROUGH OF MANHATTAN WHICH IS 2.75 FEET ABOVE MEAN SEA LEVEL AT SANDY HOOK.

CITY OF NEW YORK BOROUGH OF MANHATTAN  
OFFICE OF THE PRESIDENT  
DEPARTMENT OF PUBLIC WORKS  
BUREAU OF SEWERS AND HIGHWAYS  
**MAP**  
SHOWING A CHANGE IN THE STREET SYSTEM  
HERETOFORE LAID OUT BY  
**ADJUSTING THE DIMENSIONS**  
WITHIN THE TERRITORY BOUNDED BY  
AMSTERDAM AVE., LAUREL HILL TER. AND W. 185<sup>TH</sup> ST.  
AND  
LAYING OUT LINES AND GRADES  
FOR THE EXTENSION OF  
**W. 187<sup>TH</sup> ST.**  
BETWEEN  
AMSTERDAM AVE. AND LAUREL HILL TERRACE

DATED AUG. 14-1936

SCALE 1" = 40'

DRAWN BY R.H.B.  
CHECKED BY S. W. W.

R. H. B.  
SECTION ENGINEER

J. C. Collier  
ENGINEER OF DESIGN

CHIEF ENGINEER

Samuel Ben  
PRESIDENT BOROUGH OF MANHATTAN

Drawn 13

Filed in the Office of the Borough Engineer  
Manhattan 12/17/36

File No. 18.2 Acc. No. 27485

B