
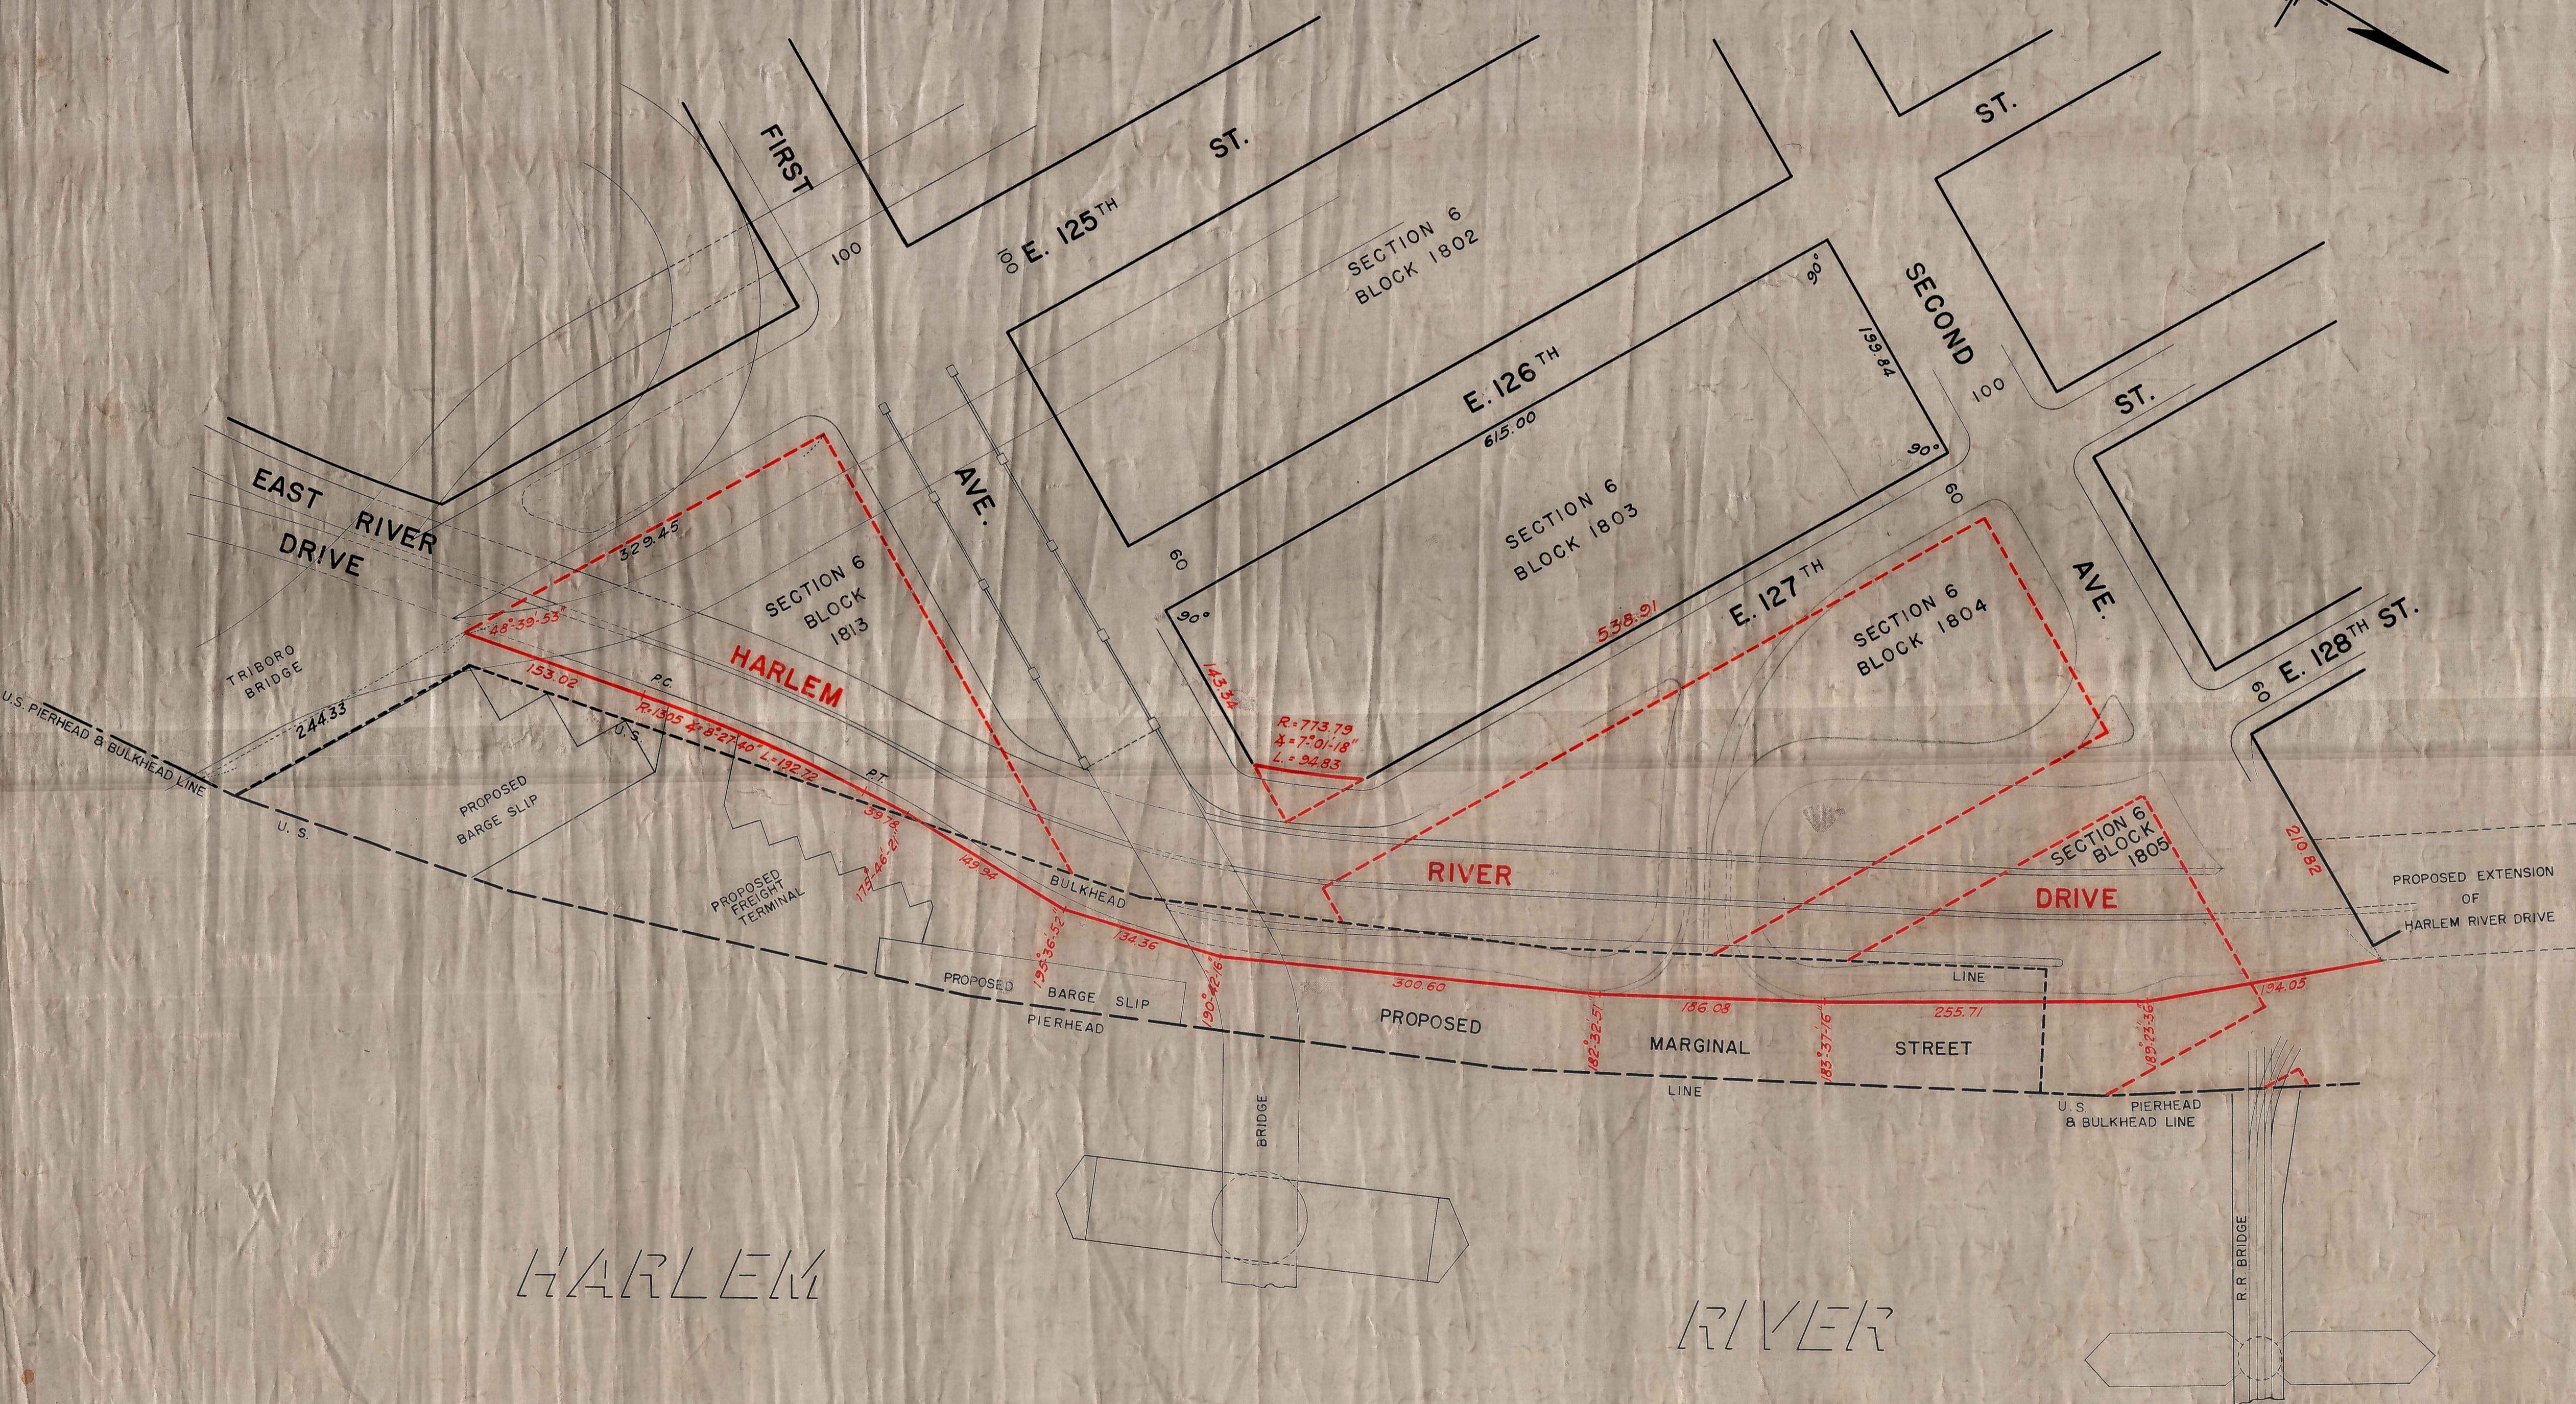


1941-1942
 1943-1944
 1945-1946
 2099-2100

LEGEND

LINES AND DIMENSIONS PREVIOUSLY ESTABLISHED AND HEREBY RETAINED
 ARE SHOWN BY FULL BLACK LINES AND BLACK FIGURES.
 LINES AND DIMENSIONS HEREBY ESTABLISHED ARE SHOWN BY FULL RED
 LINES AND RED FIGURES.
 LINES HEREBY DISCONTINUED ARE SHOWN BY DASHED RED LINES.

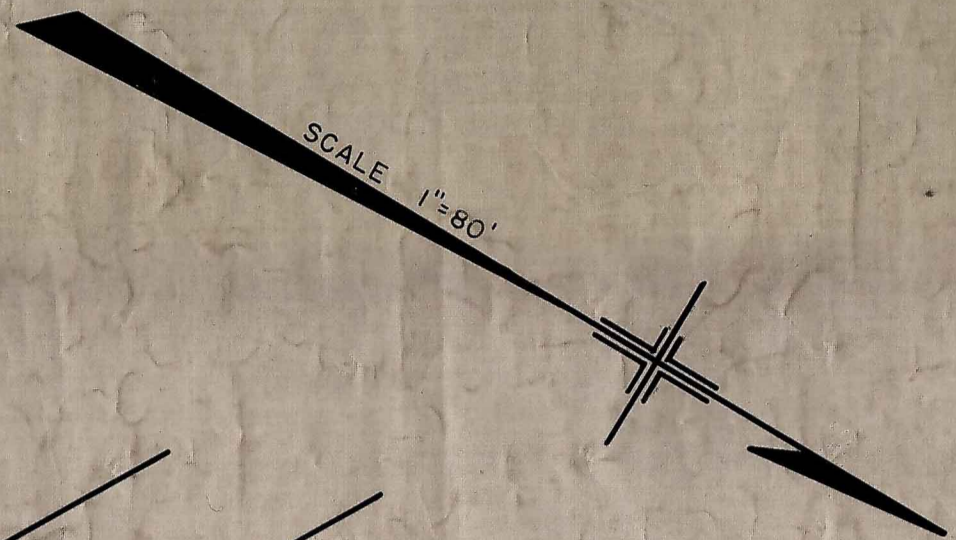

I, FRANCES LEHRICH, SECRETARY OF THE BOARD OF ESTIMATE
 OF THE CITY OF NEW YORK DO HEREBY CERTIFY THAT THIS
 MAP IS ONE OF FOUR SIMILAR MAPS ADOPTED BY THE SAID
 BOARD OF ESTIMATE ON THE 6TH DAY OF MARCH 1941
 Frances Lehrich
 SECRETARY, BOARD OF ESTIMATE

afg

HARLEM

RIVER

CITY OF NEW YORK BOROUGH OF MANHATTAN
 OFFICE OF THE PRESIDENT
 DEPARTMENT OF BOROUGH WORKS

MAP SHOWING A CHANGE IN THE STREET SYSTEM
 BY LAYING OUT
 A STREET DESIGNATED AS
HARLEM RIVER DRIVE
 ALONG THE HARLEM RIVER
 BETWEEN
 EAST 125TH STREET
 AND
 SECOND AVENUE

DRAWN BY BAP
 CHECKED BY EMT
 SECTION ENGINEER
 ENGINEER OF DESIGN

APPROVED FOR DEPT. OF DOCKS
 Commissioner of Docks

DATE: MARCH 4, 1940
 Chief Engineer

PRES. BORO. OF MANHATTAN

SCALE: 1"=80'

COMM. OF BORO. WORKS

Drawer 38-C

ACC: 28132