



DRAWN BY: *Paul*  
 CHECKED BY: *W.K.*  
 SECTION ENGINEER  
 ENGINEER OF DESIGN

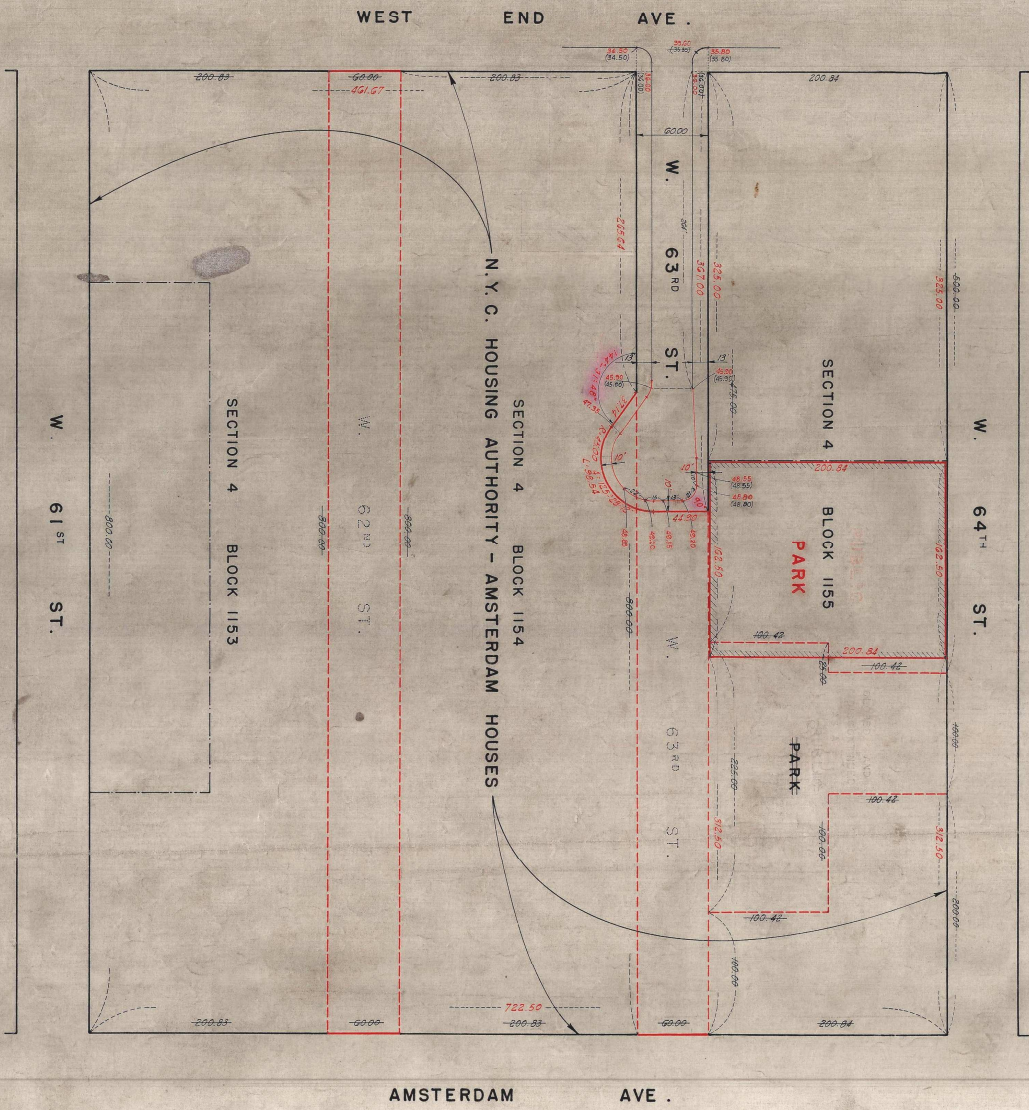

I, Hilda G. Schwartz, Secretary of the Board of Estimate and Apportionment of the City of New York, do hereby certify that this map is one of the maps approved by the Board of Estimate on the 10th day of June, 1946.  
 Hilda G. Schwartz  
 SECRETARY BOARD OF ESTIMATE  
 JUNE 10 1946

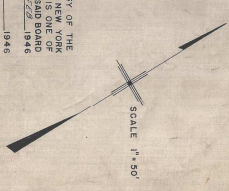

**LEGEND**

Lines and dimensions previously established and hereby retained are shown by full black lines and dimensions hereby established are shown by full red lines and red figures. Lines previously established and hereby eliminated are shown by a black line and red figures. Dimensions hereby discontinued are shown by black figures crossed by a black line. Elevations shown on this map are referred to mean sea level. A contour interval of 2.73 feet above mean sea level at Sandy Hook. Grades hereby established are shown by vertical red figures. Elevation figures are shown by vertical black figures enclosed in a parenthesis and where hereby discontinued are crossed by a black line.

**MAP SHOWING A CHANGE IN THE STREET SYSTEM BY ELIMINATING THE LINES OF WEST 62ND STREET WEST 63RD STREET WEST 64TH STREET AND OF A PARK**

CITY OF NEW YORK  
 OFFICE OF THE PRESIDENT OF THE BOROUGH OF MANHATTAN  
 DEPARTMENT OF PUBLIC WORKS

BETWEEN WEST END AVE AND AMSTERDAM AVE,  
 WEST 62ND STREET  
 BETWEEN WEST END AVE AND AMSTERDAM AVE,  
 WEST 63RD STREET  
 AND OF A  
 PARK  
 BETWEEN WEST 63RD ST. AND WEST 64TH ST.  
 JUST WEST OF AMSTERDAM AVE.  
 AND BY LAYING OUT THE LINES OF A  
 PARK  
 BETWEEN WEST 63RD ST. AND WEST 64TH ST.  
 APPROXIMATELY MIDWAY BETWEEN AMSTERDAM AVE. AND WEST END AVE.  
 AND BY ESTABLISHING GRADES FOR  
 WEST 63RD STREET  
 BETWEEN WEST END AVE. AND A LINE 367 FT. EASTERLY THEREFROM

DATE: *October 3, 1941*

RESIDENT OF MANHATTAN  
 PRESIDENT OF THE BOROUGH OF MANHATTAN  
 CHIEF ENGINEER  
 ACTIVE SECRETARY, BOARD OF ESTIMATE