


PARK

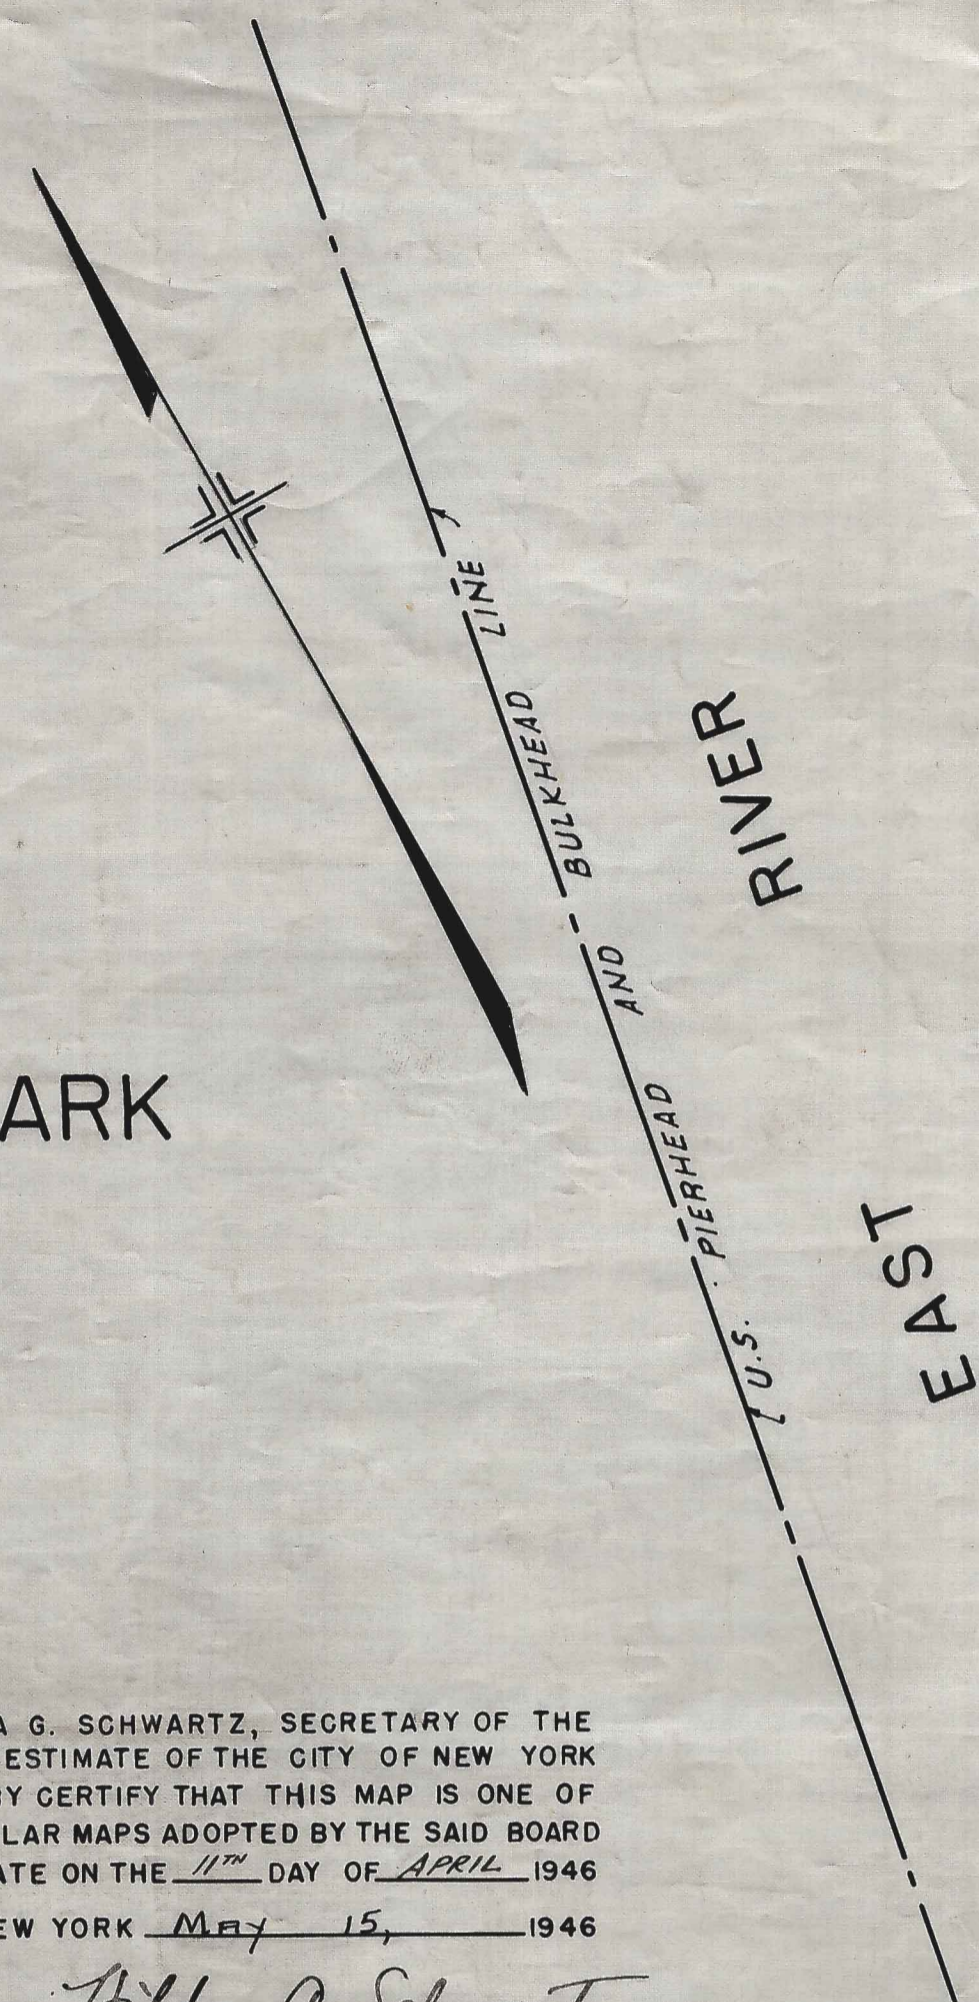

I, HILDA G. SCHWARTZ, SECRETARY OF THE BOARD OF ESTIMATE OF THE CITY OF NEW YORK DO HEREBY CERTIFY THAT THIS MAP IS ONE OF FOUR SIMILAR MAPS ADOPTED BY THE SAID BOARD OF ESTIMATE ON THE 11TH DAY OF APRIL 1946 DATED: NEW YORK MAY 15, 1946

Hilda G. Schwartz
SECRETARY BOARD OF ESTIMATE

CITY OF NEW YORK
OFFICE OF THE PRESIDENT BOROUGHS OF MANHATTAN
DEPARTMENT OF BOROUGHS WORKS

MAP SHOWING A CHANGE IN THE STREET SYSTEM
BY WIDENING A PORTION OF
EAST 10TH STREET
BETWEEN
AVENUE "D" AND FRANKLIN D. ROOSEVELT DRIVE

SCALE: 1" = 50'

DATE: JAN. 15, 1946.

Hugo Rogers
PRESIDENT BOROUGHS OF MANHATTAN
Ralph J. Lewis
CONSULTING ENGINEER

NOTES

- LINES AND DIMENSIONS PREVIOUSLY ESTABLISHED AND HEREBY RETAINED ARE SHOWN BY FULL BLACK LINES AND BLACK FIGURES.
- LINES AND DIMENSIONS HEREBY ESTABLISHED ARE SHOWN BY FULL RED LINES AND RED FIGURES.
- LINES PREVIOUSLY ESTABLISHED AND HEREBY ELIMINATED ARE SHOWN BY DASHED RED LINES.

DRAWN BY: G.L.
CHECKED BY: F.S.
William D. Moffatt
SECTION ENGINEER
J.C. Collyer
ENGINEER OF DESIGN