

SCALES: HOR. 1" = 30'
VER. 1" = 10'

B.P.M. DATUM 0.0

PROFILE

ALONG THE WESTERLY CURB LINE OF FIRST AVENUE

LEGEND

LINES AND DIMENSIONS PREVIOUSLY ESTABLISHED AND HEREBY RETAINED ARE SHOWN BY FULL BLACK LINES AND BLACK FIGURES.

LINES AND DIMENSIONS HEREBY ESTABLISHED ARE SHOWN BY FULL RED LINES AND RED FIGURES.

GRADES HEREBY ESTABLISHED ARE SHOWN BY VERTICAL RED FIGURES.

GRADES PREVIOUSLY ESTABLISHED AND HEREBY ABOLISHED ARE SHOWN BY VERTICAL BLACK FIGURES CROSSED BY A BLACK LINE.

EXISTING SURFACE ELEVATIONS ARE SHOWN BY VERTICAL BLACK FIGURES ENCLOSED IN PARENTHESES.

ELEVATIONS SHOWN ON THIS MAP ARE REFERRED TO THE BOROUGH WORKS DATUM OF THE BOROUGH OF MANHATTAN WHICH IS 2.75 FEET ABOVE MEAN SEA LEVEL AT SANDY HOOK.


ELEVATIONS AT TOP OF CURB SHOWN THUS..... 32.00C

ELEVATIONS AT PAVEMENT SHOWN THUS..... 31.80

I, HILDA G. SCHWARTZ, SECRETARY OF THE BOARD OF ESTIMATE OF THE CITY OF NEW YORK DO HEREBY CERTIFY THAT THIS MAP IS ONE OF FIVE SIMILAR MAPS ADOPTED BY THE SAID BOARD OF ESTIMATE ON THE 19TH DAY OF AUGUST, 1948

DATED: NEW YORK September 28, 1948

Hilda G. Schwartz
SECRETARY BOARD OF ESTIMATE

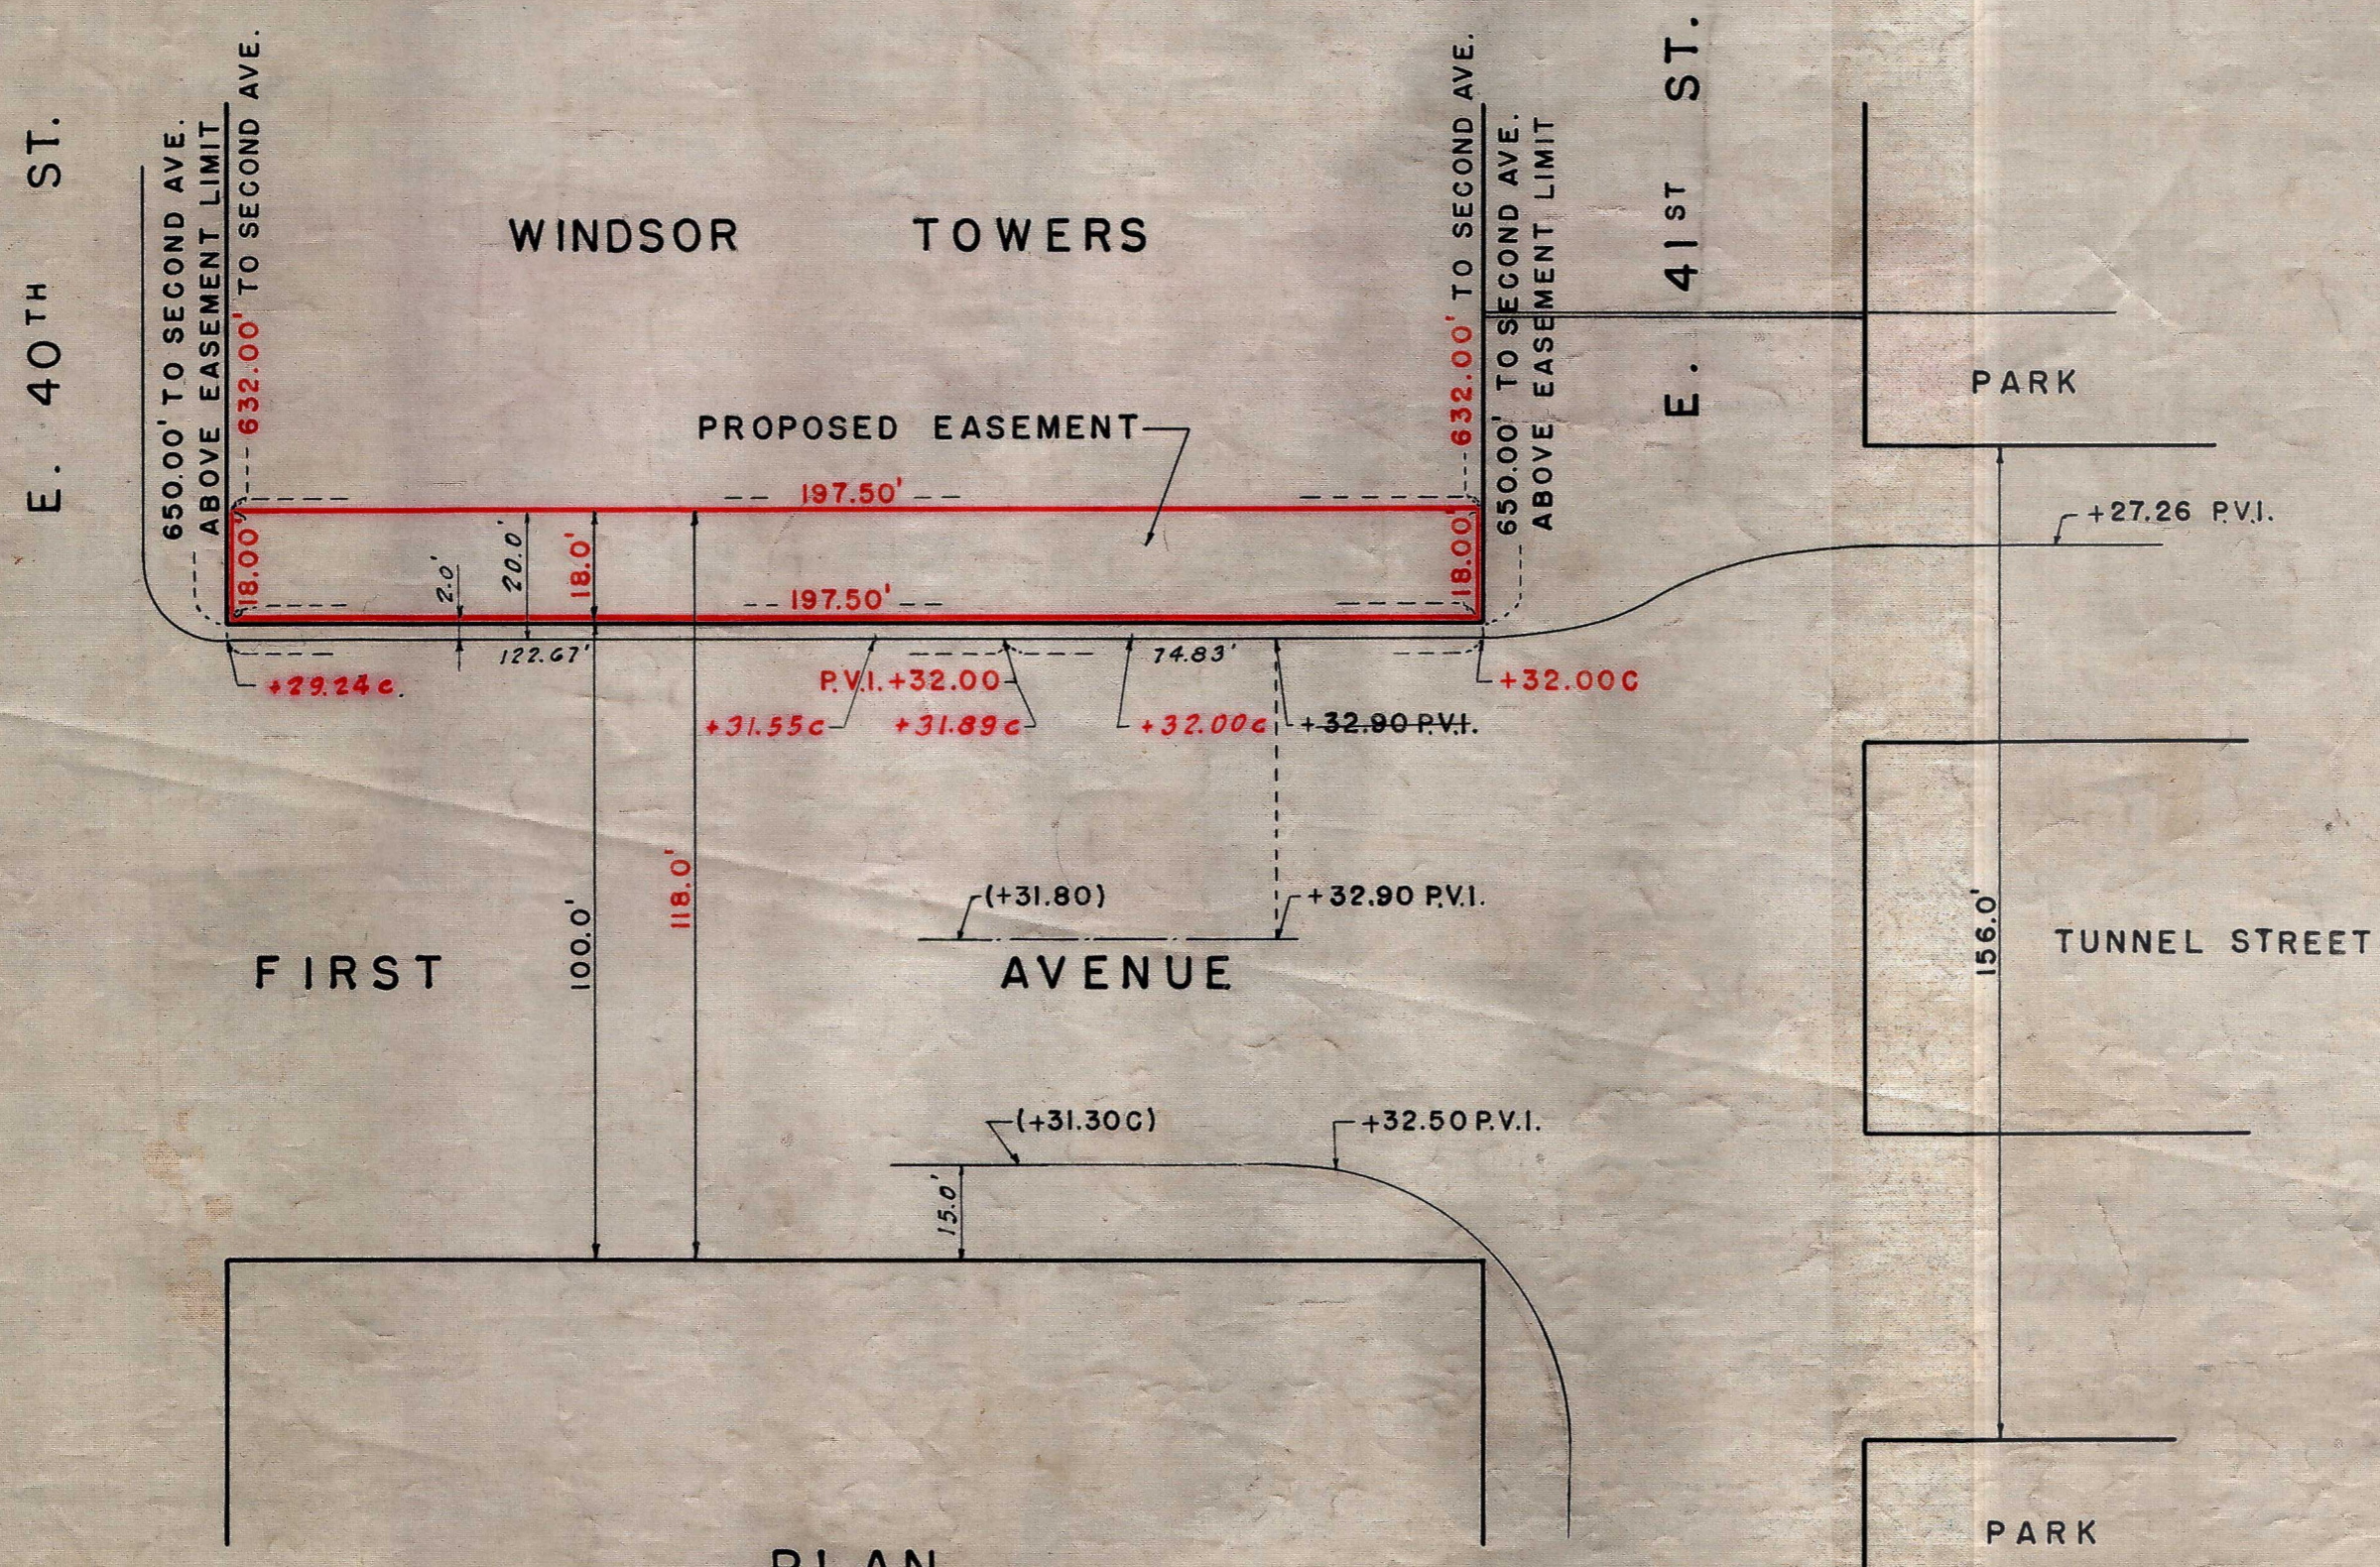

PLAN

SCALE: 1" = 30'

CITY OF NEW YORK
OFFICE OF THE PRESIDENT BOROUGH OF MANHATTAN
DEPARTMENT OF BOROUGH WORKS

MAP SHOWING A CHANGE IN THE STREET SYSTEM
BY WIDENING
FIRST AVENUE
ALONG ITS WESTERLY SIDE
BETWEEN EAST 40TH STREET AND EAST 41ST STREET
BELOW A DESIGNATED UPPER LIMITING PLANE
AND BY
ESTABLISHING GRADES THEREFOR

DATED: DECEMBER 3, 1947

SCALES AS SHOWN

Hugo Elogers
PRESIDENT BOROUGH OF MANHATTAN

Michael R. ...
CHIEF ENGINEER

Robert ...
CHIEF ENGINEER OF DESIGN

DRAWN BY: *H. Waksman*
CHECKED BY: *St. Kauf*
William ...
SECTION ENGINEER
J.C. Collyer
ENGINEER OF DESIGN