
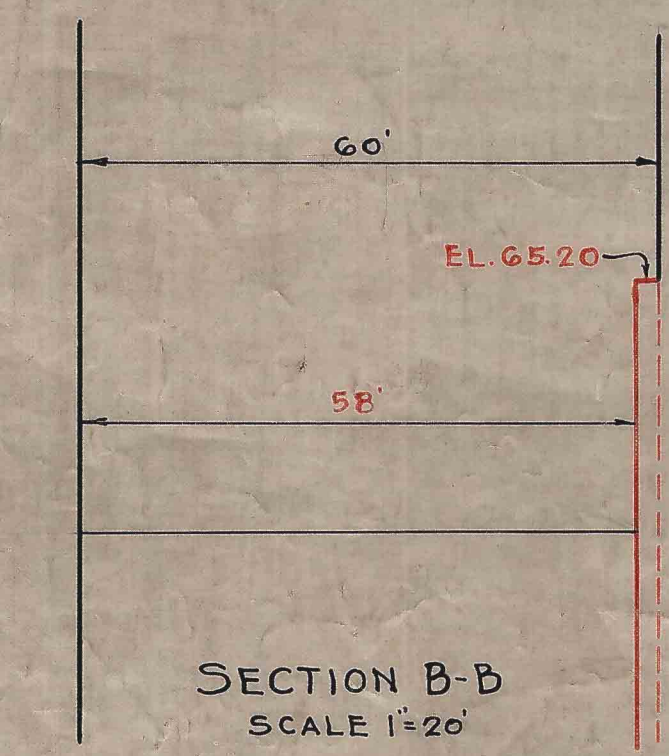


LEGEND

LINES AND DIMENSIONS PREVIOUSLY ESTABLISHED AND HEREBY RETAINED ARE SHOWN BY FULL BLACK LINES AND BLACK FIGURES.
 LINES AND DIMENSIONS HEREBY ESTABLISHED ARE SHOWN BY FULL RED LINES AND RED FIGURES.
 LINES PREVIOUSLY ESTABLISHED AND HEREBY DISCONTINUED ARE SHOWN BY DASHED RED LINES.
 GRADES HEREBY ESTABLISHED ARE SHOWN BY VERTICAL RED FIGURES.
 GRADES PREVIOUSLY ESTABLISHED AND HEREBY ABOLISHED ARE SHOWN BY VERTICAL BLACK FIGURES CROSSED BY A BLACK LINE.
 EXISTING SURFACE ELEVATIONS ARE SHOWN BY VERTICAL BLACK FIGURES ENCLOSED IN PARENTHESES.
 GRADES PREVIOUSLY ESTABLISHED AND HEREBY RETAINED ARE SHOWN BY VERTICAL BLACK FIGURES.
 ELEVATIONS SHOWN ON THIS MAP ARE REFERRED TO THE BOROUGH WORKS DATUM OF THE BOROUGH OF MANHATTAN WHICH IS 2.75 FEET ABOVE MEAN SEA LEVEL AT SANDY HOOK.
 ELEVATIONS AT TOP OF CURB SHOWN THUS 38.44C, 70.30C

I, HILDA G. SCHWARTZ, SECRETARY OF THE BOARD OF ESTIMATE OF THE CITY OF NEW YORK DO HEREBY CERTIFY THAT THIS MAP IS ONE OF FIVE SIMILAR MAPS ADOPTED BY THE SAID BOARD OF ESTIMATE ON THE 16TH DAY OF DEC 1948
 DATED: NEW YORK JANUARY 26, 1949
Hilda G. Schwartz
 SECRETARY, BOARD OF ESTIMATE

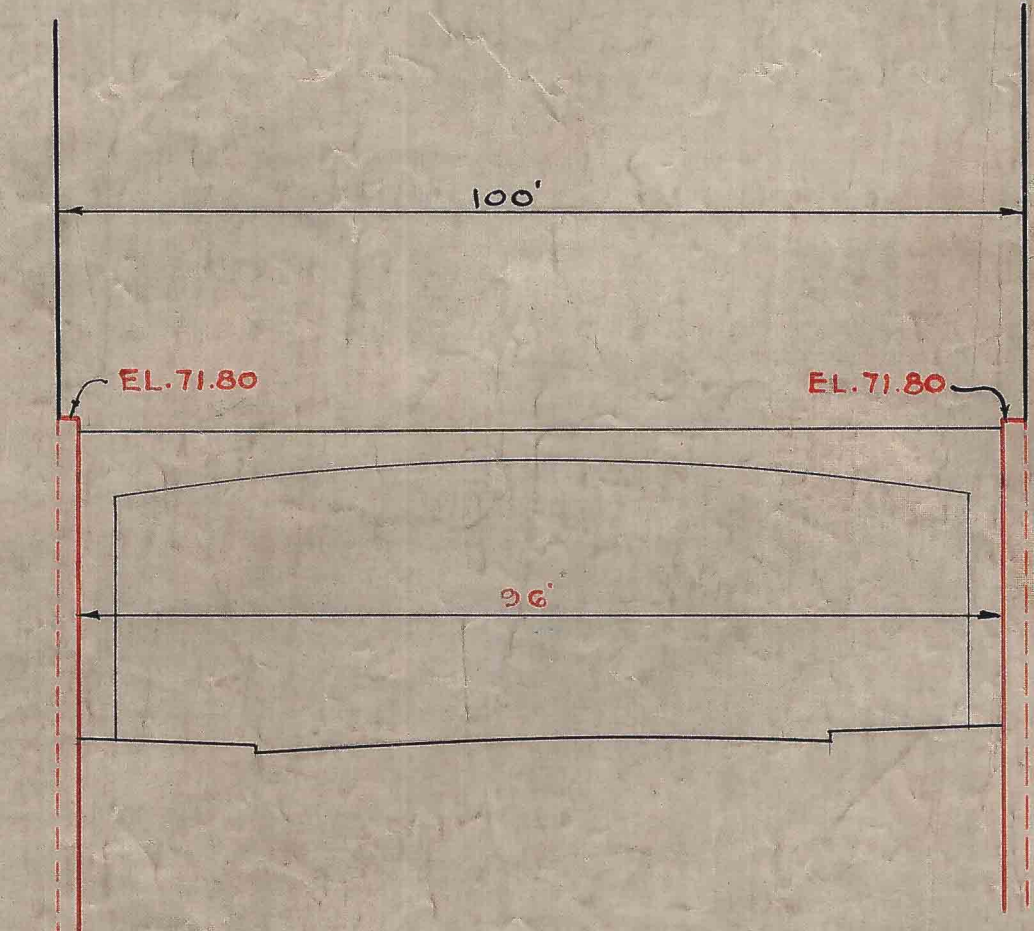

CITY OF NEW YORK
 OFFICE OF THE PRESIDENT, BOROUGH OF MANHATTAN
 DEPARTMENT OF BOROUGH WORKS

MAP SHOWING A CHANGE IN THE STREET SYSTEM BY MODIFYING THE LINES AND GRADES OF EAST 42ND STREET AND EAST 43RD STREET BETWEEN FIRST AVENUE AND SECOND AVENUE AND BY ESTABLISHING THE LINES AND GRADES OF TUDOR CITY PLACE BETWEEN EAST 41ST STREET AND EAST 43RD STREET
 DATED: APRIL 8, 1948 SCALE 1" = 50'

Henry Rogers
 PRESIDENT, BOROUGH OF MANHATTAN

Michael C. ...
 CHIEF ENGINEER

Ralph ...
 CHIEF ENGINEER OF DESIGN

DRAWN BY *Ed ...*
 CHECKED BY *H. W. ...*
William ...
 SECTION ENGINEER

J.C. Collins
 ENGINEER OF DESIGN

ACC. No: 28953