



Map, Plan and Profiles of the
Laying Out and Extending West 172nd,
West 173rd and West 175th Streets, from
Fort Washington Avenue to Buena Vista Avenue;
A New Avenue between Fort Washington Avenue
and Buena Vista Avenue, from West 173rd Street
to West 177th Street; The Widening of Buena Vista
Avenue from the present terminus of Haven Avenue
to West 177th Street; and the Change of Grade on
West 176th Street from Fort Washington Avenue to
Buena Vista Avenue, in the 12th Ward, Borough of
Manhattan, City of New York.

J. O. B. Webster Engineer of Street Openings.

Note: Old Streets and their Grades, shown in Black lines and figures
New Streets, with their Grades fixed and established, shown in
Red lines and figures.
All Elevations, above City Datum.
Horizontal Distances between Grades, shown in Blue.

Horizontal Scale: — 1 inch = 50 feet
Vertical Scale: — 1 inch = 30 feet.

Copied from the Original
March 9th 1932
Copied by: Richard Freund.
Checked by: Augustin I. Gordon.

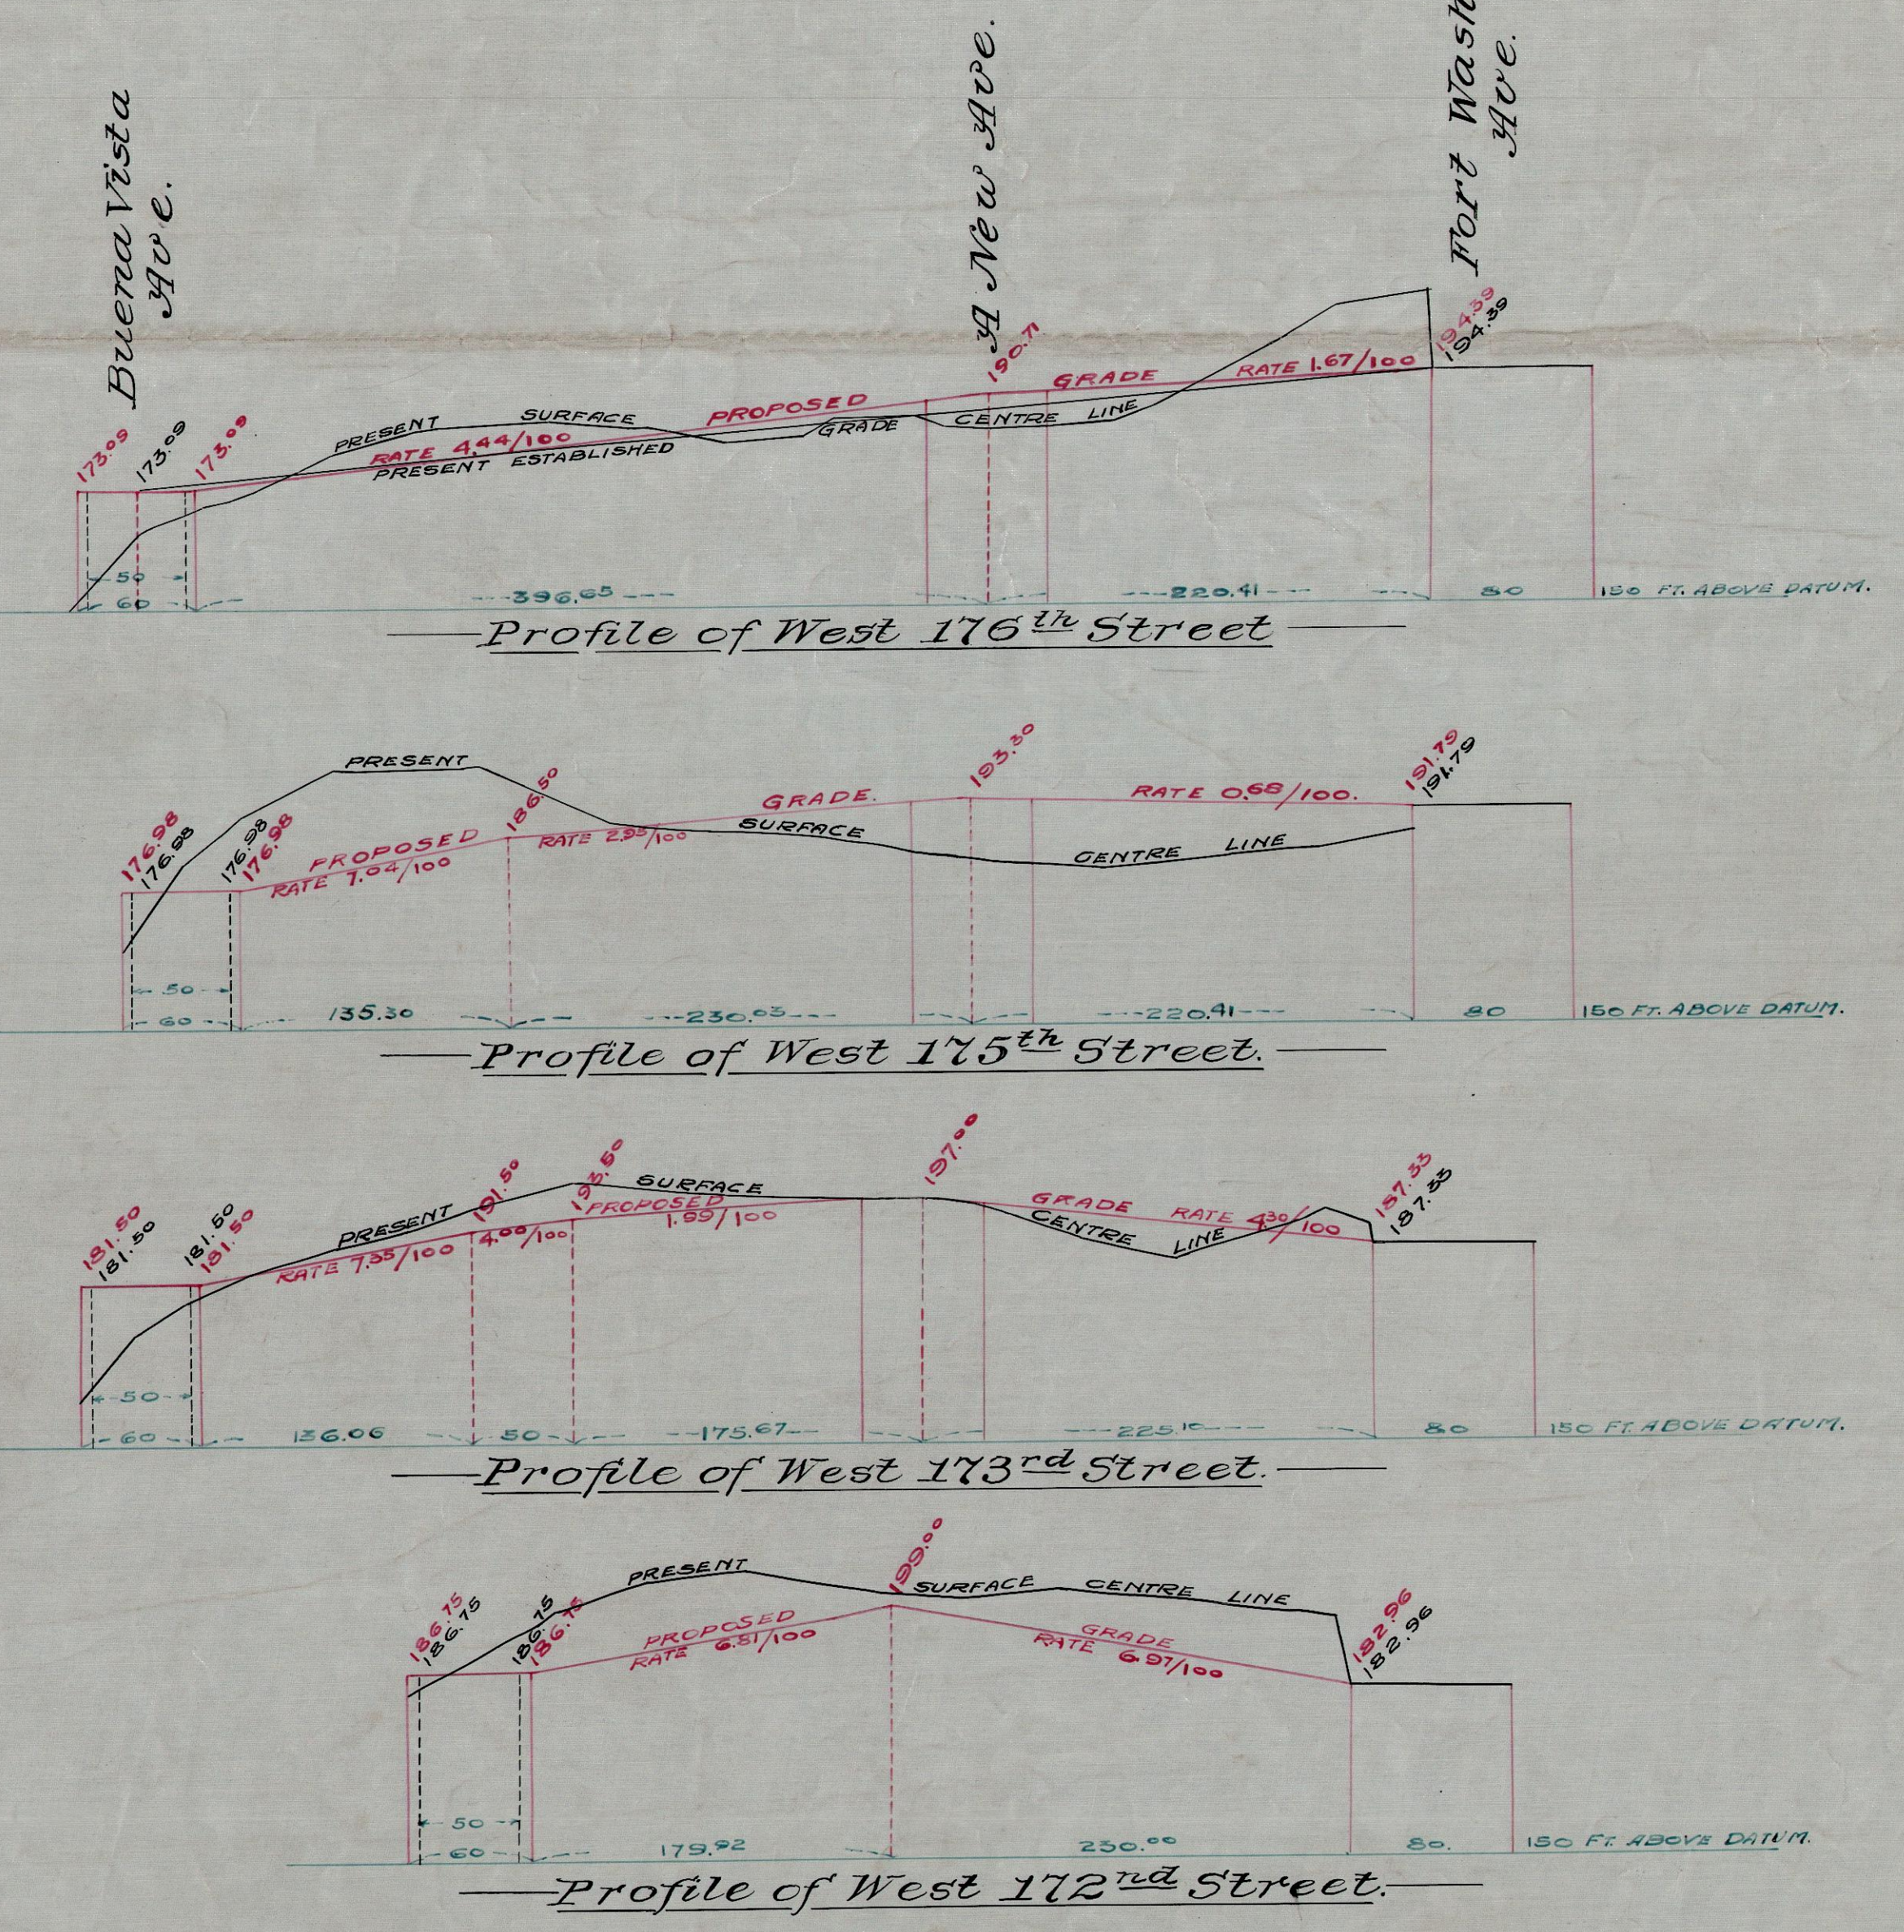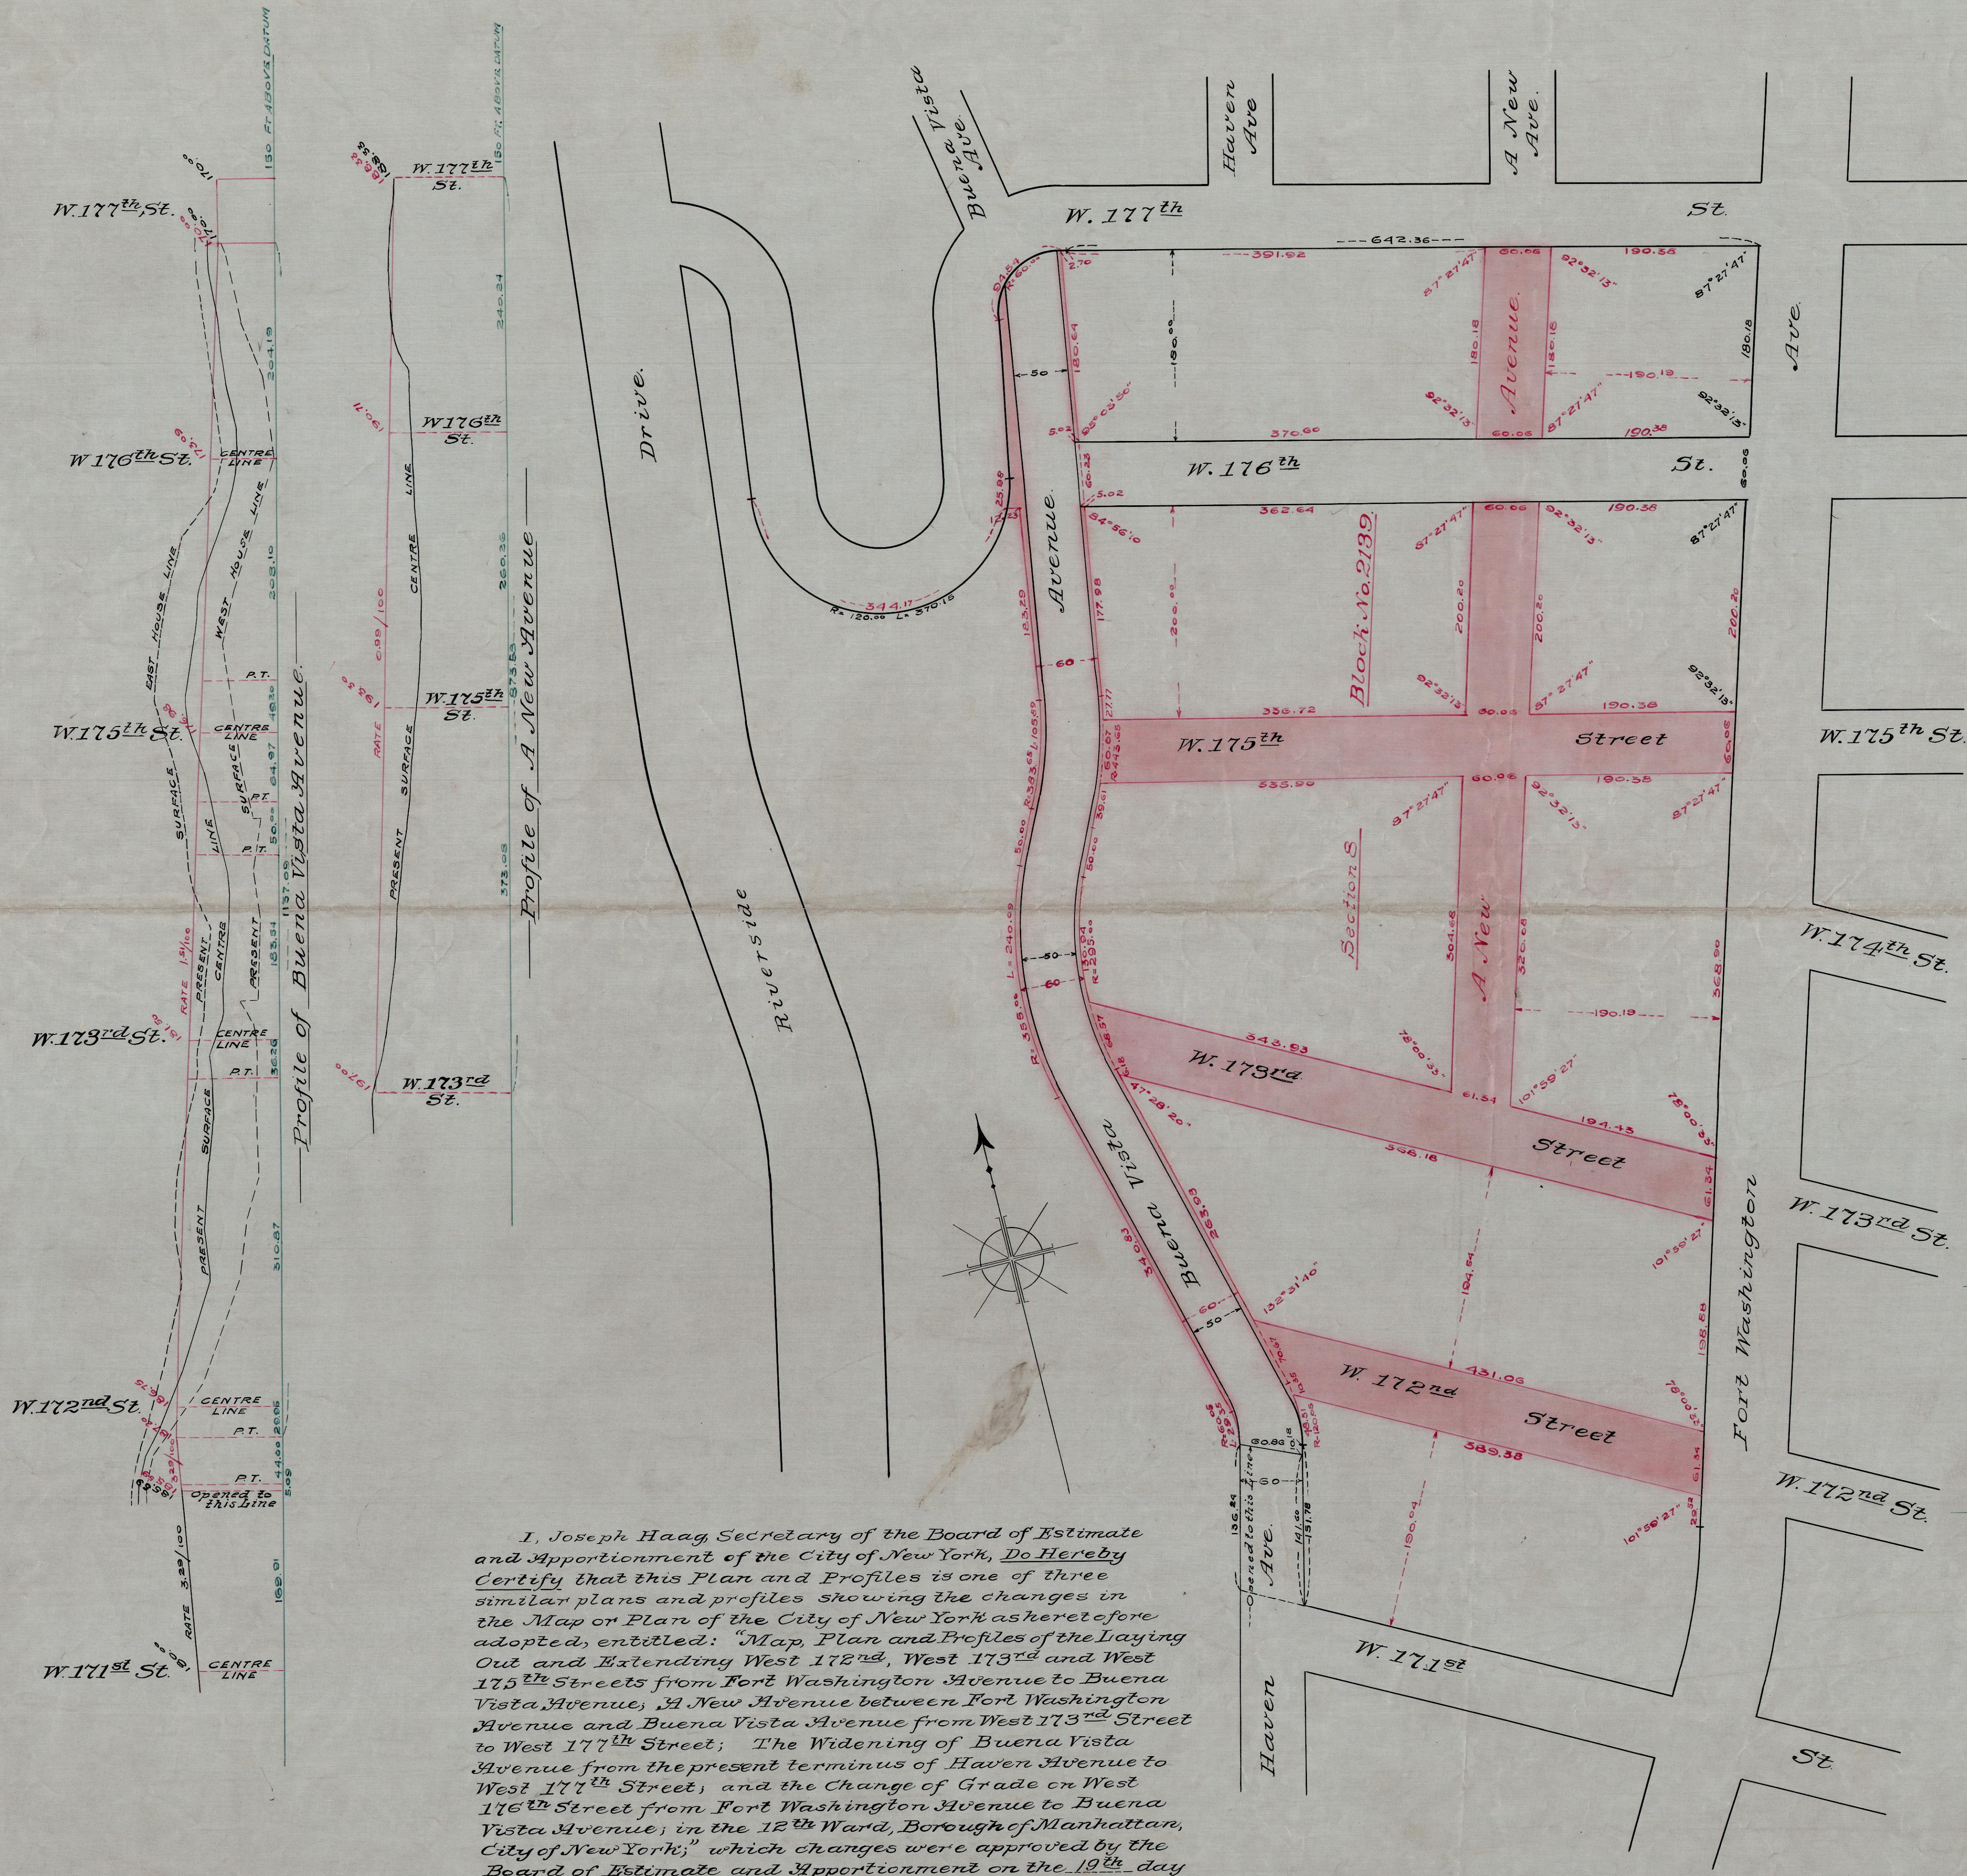

I, Joseph Haag, Secretary of the Board of Estimate and Apportionment of the City of New York, Do Hereby Certify that this Plan and Profiles is one of three similar plans and profiles showing the changes in the Map or Plan of the City of New York as heretofore adopted, entitled: "Map, Plan and Profiles of the Laying Out and Extending West 172nd, West 173rd and West 175th Streets from Fort Washington Avenue to Buena Vista Avenue; A New Avenue between Fort Washington Avenue and Buena Vista Avenue from West 173rd Street to West 177th Street; The Widening of Buena Vista Avenue from the present terminus of Haven Avenue to West 177th Street; and the Change of Grade on West 176th Street from Fort Washington Avenue to Buena Vista Avenue, in the 12th Ward, Borough of Manhattan, City of New York," which changes were approved by the Board of Estimate and Apportionment on the 19th day of April, 1907, and by the Mayor on the 14th day of May, 1907. Under authority of the Greater New York Charter.

Dated this 30th day of July 1907

Joseph Haag Secretary of the Board of Estimate and Apportionment.

Received and Filed Aug. 1st 1907

C. R. Hatton Map Clerk, N. Y. C.

FILE D 82.21
XD 96.21