


HUDSON RIVER.

RIVER.

SEE DETAIL BELOW.

LEGEND.
 LINES AND DIMENSIONS PREVIOUSLY LAID OUT AND RETAINED ARE SHOWN BY FULL BLACK LINES AND BLACK FIGURES.
 LINES AND DIMENSIONS HEREBY ESTABLISHED ARE SHOWN BY FULL RED LINES AND RED FIGURES.
 LINES HEREBY DISCONTINUED ARE SHOWN BY DOT AND DASH RED LINES.
 GRADES PREVIOUSLY ESTABLISHED AND RETAINED ARE SHOWN BY VERTICAL BLACK FIGURES.
 GRADES PREVIOUSLY ESTABLISHED AND HEREBY ABOLISHED ARE SHOWN BY VERTICAL BLACK FIGURES CROSSED BY A BLACK LINE.
 GRADES HEREBY ESTABLISHED ARE SHOWN BY VERTICAL RED FIGURES.
 ELEVATIONS SHOWN ON THIS MAP ARE REFERRED TO THE PUBLIC WORKS DATUM OF THE BOROUGH OF MANHATTAN, WHICH IS 2.75 FEET ABOVE MEAN SEA LEVEL AT SANDY HOOK.

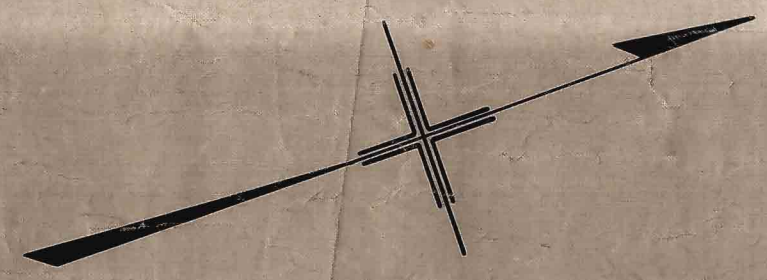

DETAIL SHOWING NORTHWEST CORNER OF ADDITION TO FORT WASHINGTON PARK.

CITY OF NEW YORK, BOROUGH OF MANHATTAN
 OFFICE OF THE PRESIDENT
 DEPARTMENT OF PUBLIC WORKS
 BUREAU OF ENGINEERING

MAP SHOWING A CHANGE IN THE STREET AND PARK SYSTEM HERETOFORE LAID OUT WITHIN THE TERRITORY BOUNDED BY W. 155TH STR., RIVERSIDE DRIVE, FORT WASHINGTON PARK AND THE HUDSON RIVER.

BY
LAYING OUT LINES AND GRADES FOR RIVERSIDE DRIVE WEST W. 155TH STR. TO W. 165TH STR.
WIDENING AND CHANGING THE GRADE OF WEST 158TH STREET BETWEEN RIVERSIDE DRIVE AND THE HUDSON RIVER.
WIDENING RIVERSIDE DRIVE NEAR W. 168TH STR.
LAYING OUT AN ADDITION TO FORT WASHINGTON PARK BETWEEN W. 158TH STR. AND FORT WASHINGTON PARK.
LAYING OUT A PUBLIC PARK BETWEEN RIVERSIDE DRIVE AND RIVERSIDE DRIVE W. AT W. 162ND STR.

Dated March 1, 1913.
 24924

I, JAMES MATTHEWS, ASSISTANT SECRETARY OF THE BOARD OF ESTIMATE AND APPOINTMENT OF THE CITY OF NEW YORK, DO HEREBY CERTIFY THAT THIS MAP IS ONE OF THREE SIMILAR MAPS MADE AT THE DIRECTION OF AND APPROVED BY THE BOARD OF ESTIMATE AND APPOINTMENT ON THE 22ND DAY OF MARCH, 1913, AND APPROVED BY THE MAYOR ON THE 7TH DAY OF APRIL, 1913, SUPERSEDING ALL MAPS HERETOFORE FILED AFFECTING THE AREA ENCOMPASSED BY SAID MAPS IN SO FAR AS IT MAKES ANY CHANGES THEREIN.
 PREPARED FOR THE BOARD OF ESTIMATE AND APPOINTMENT UNDER AUTHORITY OF THE CHARTER OF THE CITY OF NEW YORK.
 DATED NEW YORK, OCTOBER 15, 1912.
 James Matthews
 ASSISTANT SECRETARY
 BOARD OF ESTIMATE AND APPOINTMENT

Drawn by G. C. MONTAGNOLI
 Checked by W. F. FOLEY