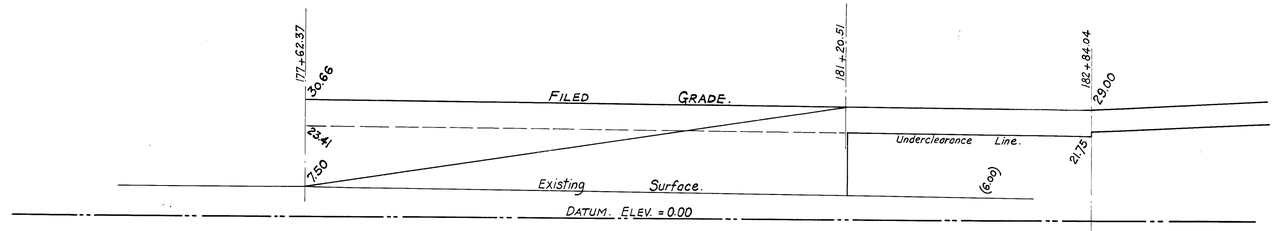

PROFILE
Hor. Scale 1"=50'
Vert. Scale 1"=20'

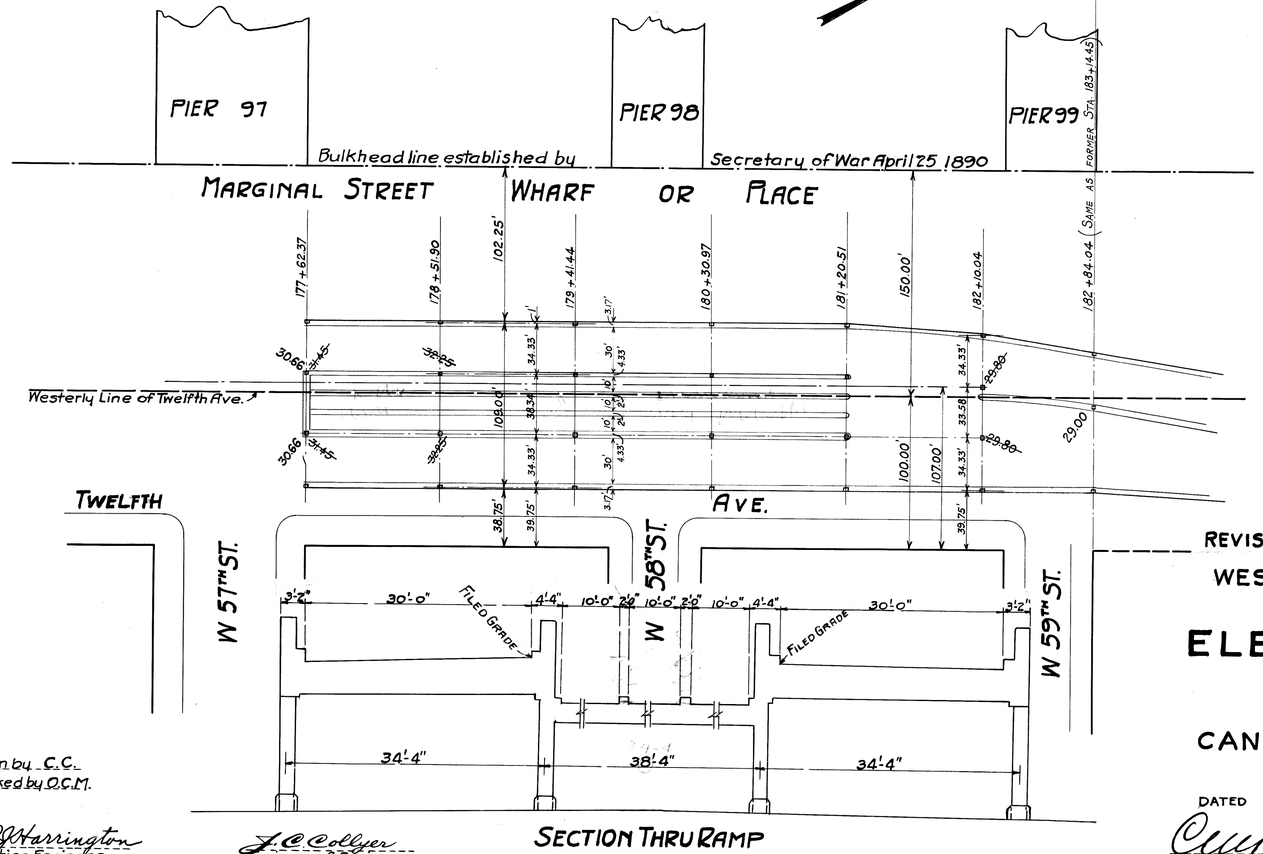

SECTION THRU RAMP

Drawn by C.C.
Checked by O.C.M.

P.J. Harrington
Section Engineer

J.C. Collyer
Engineer of Design

I, PETER J. McGOWAN, SECRETARY OF THE BOARD OF ESTIMATE AND APPORTIONMENT OF THE CITY OF NEW YORK, DO HEREBY CERTIFY THAT THIS MAP IS ONE OF THREE SIMILAR MAPS MADE AT THE DIRECTION OF, AND ADOPTED, BY, THE SAID BOARD OF ESTIMATE AND APPORTIONMENT ON THE 5TH DAY OF June 1931 AND APPROVED BY THE MAYOR ON THE 10TH DAY OF June 1931 SUPERSEDING ALL MAPS HERETOFORE FILED AFFECTING THE AREA EMBRACED BY SAID MAP IN SO FAR AS IT MAKES ANY CHANGES THEREIN.

PREPARED FOR THE BOARD OF ESTIMATE AND APPORTIONMENT UNDER AUTHORITY OF THE CHARTER OF THE CITY OF NEW YORK.

DATED, NEW YORK Sept 19, 1931

Peter J. McGowan
SECRETARY,
BOARD OF ESTIMATE AND APPORTIONMENT.

LEGEND

Lines and dimensions previously established and hereby retained are shown by full black lines and black figures
Lines and dimensions hereby established are shown by full Red lines and Red figures.
Grades hereby established are shown by vertical Red figures.
Existing surface elevations are shown by vertical Black figures enclosed in a Parenthesis.
Grades previously established and hereby retained are shown by vertical Black figures.
Grades previously established and hereby abolished are shown by vertical Black figures crossed by a Black line.
Elevations shown on this map are referred to the Public Works Datum of the Borough of Manhattan, which is 2.75 feet above Mean Sea Level at Sandy Hook.

CITY OF NEW YORK BOROUGH OF MANHATTAN
OFFICE OF THE PRESIDENT
DEPARTMENT OF PUBLIC WORKS
BUREAU OF ENGINEERING

AMENDED MAP OR PLAN

REVISING THE LINES GRADES AND COLUMN LOCATIONS
BETWEEN
WEST 57TH STREET AND WEST 59TH STREET
AS SHOWN ON
MAP OR PLAN LAYING OUT AN

ELEVATED PUBLIC HIGHWAY

WITH RAMP APPROACHES
ALONG THE WATERFRONT OF THE HUDSON RIVER
FROM
CANAL STREET TO WEST 59TH STREET
PURSUANT TO CHAPTER 484 OF THE LAWS OF 1926

DATED MAY 11 1931

CHIEF ENGINEER

SCALES AS SHOWN

PRESIDENT BOROUGH OF MANHATTAN

Filed in Office of Clerk Borough of Manhattan 9/22/31

FILE NO. 42.5 ACC. NO. 26668

Drawer 12

(3)