


SHERIFF STREET

STREET

BROOME STREET

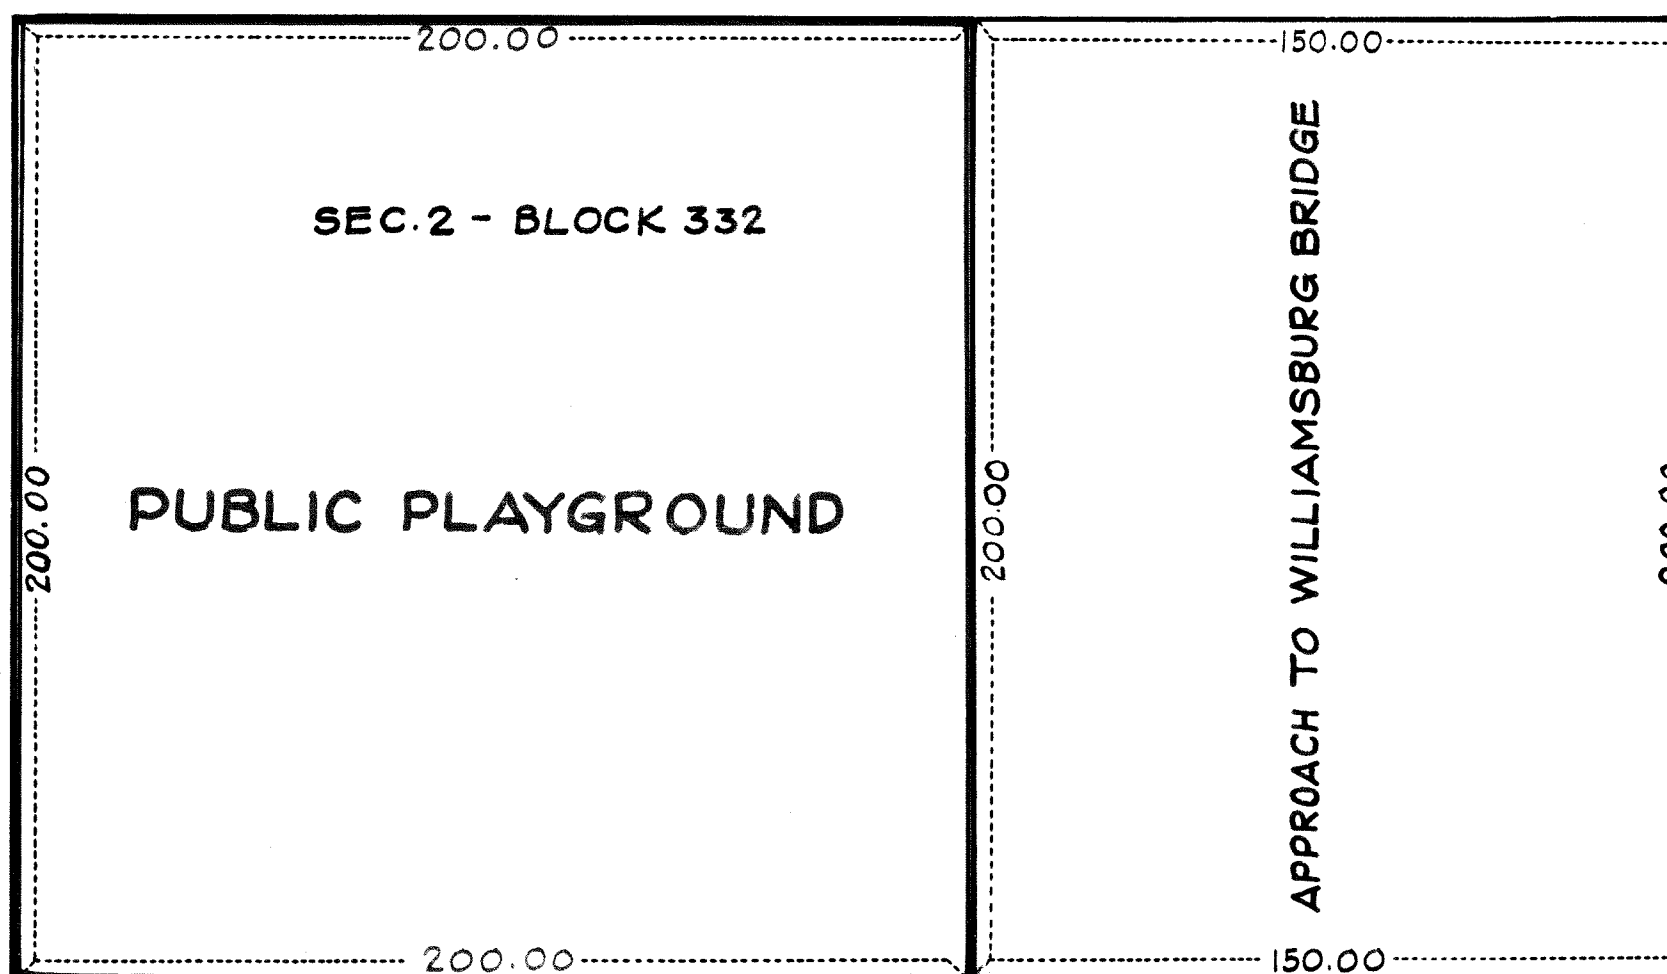

COLUMBIA STREET

STREET

DELANCEY STREET

I, PETER J. MCGOWAN, SECRETARY OF THE BOARD OF ESTIMATE AND APPORTIONMENT OF THE CITY OF NEW YORK, DO HEREBY CERTIFY THAT THIS MAP IS ONE OF THREE SIMILAR MAPS MADE AT THE DIRECTION OF, AND ADOPTED, BY, THE SAID BOARD OF ESTIMATE AND APPORTIONMENT ON THE 23rd DAY OF Oct, 1931, AND APPROVED BY THE MAYOR ON THE 30th DAY OF Oct, 1931 SUPERSEDING ALL MAPS HERETOFORE FILED AFFECTING THE AREA EMBRACED BY SAID MAP IN SO FAR AS IT MAKES ANY CHANGES THEREIN.

PREPARED FOR THE BOARD OF ESTIMATE AND APPORTIONMENT UNDER AUTHORITY OF THE CHARTER OF THE CITY OF NEW YORK.
DATED, NEW YORK, Nov. 25, 1931.

Peter J. McGowan
SECRETARY,
BOARD OF ESTIMATE AND APPORTIONMENT

LEGEND

LINES AND DIMENSIONS PREVIOUSLY LAID OUT AND RETAINED ARE SHOWN BY FULL BLACK LINES AND BLACK FIGURES.
DIMENSIONS HEREBY ESTABLISHED ARE SHOWN BY RED FIGURES.
AREA ENCLOSED BY FULL RED LINE IS HEREBY LAID OUT AS A PUBLIC PLAYGROUND.

CITY OF NEW YORK, BOROUGH OF MANHATTAN
OFFICE OF THE PRESIDENT
DEPARTMENT OF PUBLIC WORKS
BUREAU OF ENGINEERING

MAP SHOWING A CHANGE IN THE CITY PLAN AS HERETOFORE LAID OUT WITHIN THE TERRITORY BOUNDED BY BROOME STREET, SHERIFF STREET, DELANCEY STREET AND COLUMBIA STREET

BY LAYING OUT
A PUBLIC PLAYGROUND

ON THE NORTHERLY SIDE OF
BROOME STREET

BETWEEN COLUMBIA STREET AND SHERIFF STREET

DATED MAY, 29, 1931.

SCALE: 1"=40'

William M. Goldberger
CHIEF ENGINEER

William J. ...
PRESIDENT BORO OF MANHATTAN

DRAWN BY: MGOLOBERG
CHECKED BY: W. M.

William M. Goldberger
ACTING SECTION ENGINEER

J. C. Collyer
ENGINEER OF DESIGN

Drawn 12

Filed in Office of Chief Manhattan
12/8/31 G.A. Sauer

FILE No. 52.2 Acc. No. 266 98