



PLAN
SCALE: 1"=20'

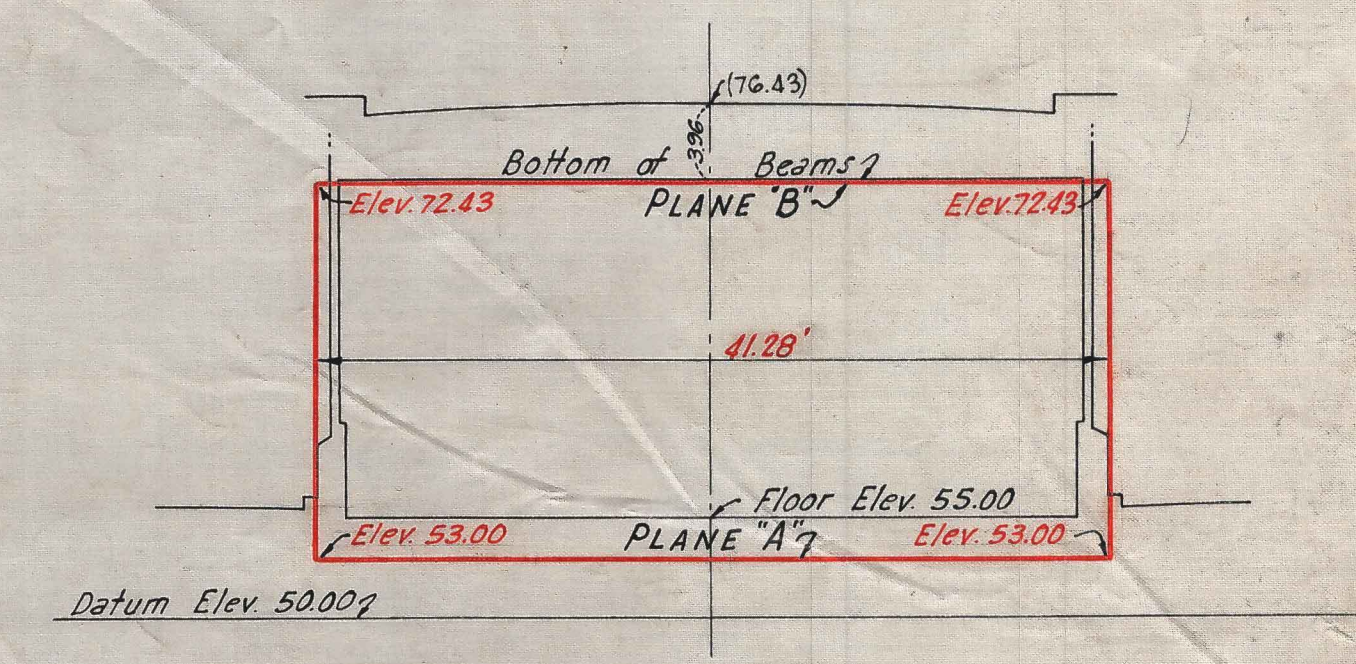

SECTION A-A
SCALE: 1"=10'

LEGEND

LINES AND DIMENSIONS PREVIOUSLY ESTABLISHED AND HEREBY RETAINED ARE SHOWN BY FULL BLACK LINES AND BLACK FIGURES.
EXISTING GRADES ARE SHOWN BY VERTICAL BLACK FIGURES ENCLOSED IN A PARENTHESIS.
VOLUME OF PARK AVENUE TO BE CLOSED WITHIN PLANES "A" AND "B", AS SHOWN ON PROFILE, IS BOUNDED BY FULL RED LINES.
ELEVATIONS SHOWN ON THIS MAP ARE REFERRED TO THE BOROUGH WORKS DATUM OF THE BOROUGH OF MANHATTAN WHICH IS 2.750 FEET ABOVE MEAN SEA LEVEL AT SANDY HOOK.

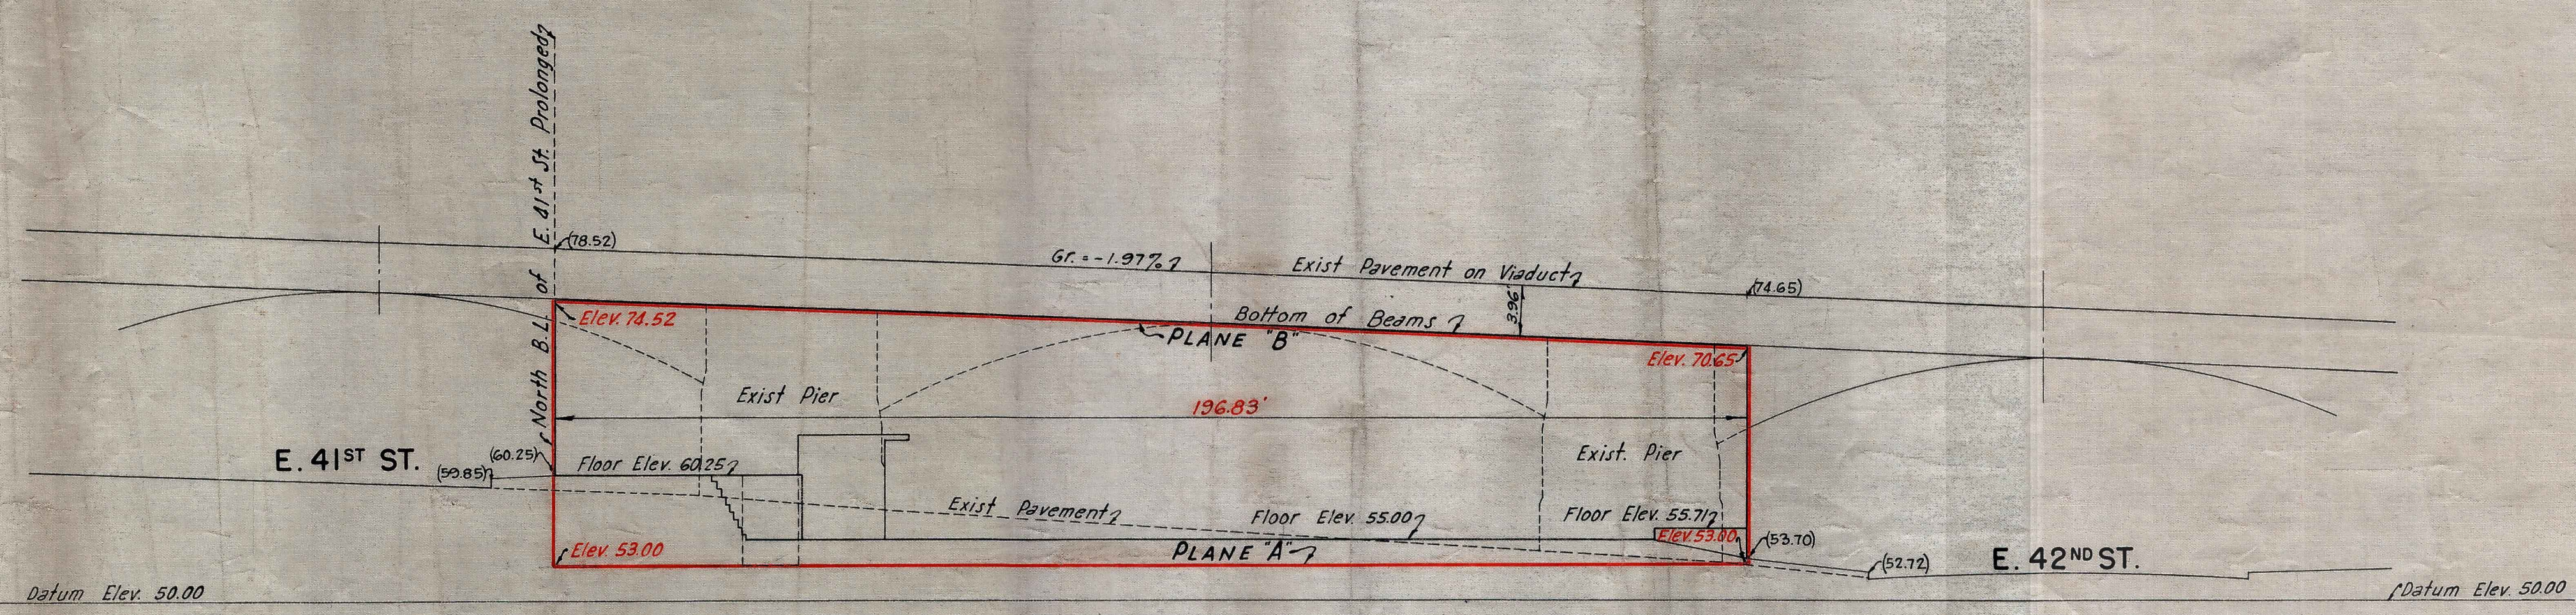

PROFILE
(ALONG ϕ OF PARK AVE.)
SCALES: HOR. 1"=20'
VERT. 1"=10'

CITY OF NEW YORK
OFFICE OF THE PRESIDENT BOROUGH OF MANHATTAN
DEPARTMENT OF BOROUGH WORKS
MAP SHOWING A CHANGE IN THE STREET SYSTEM
BY CLOSING AND DISCONTINUING A VOLUME
OF
PARK AVENUE
WITHIN INDICATED PLANES
BETWEEN
EAST 41ST STREET AND EAST 42ND STREET
PURSUANT TO CHAPTER 15, TITLE "E" OF THE
ADMINISTRATIVE CODE OF THE CITY OF NEW YORK

DATED: APRIL 30, 1941

I, **FRANCES LEHRICH**, SECRETARY OF THE BOARD OF ESTIMATE OF THE CITY OF NEW YORK DO HEREBY CERTIFY THAT THIS MAP IS ONE OF FOUR SIMILAR MAPS ADOPTED BY THE SAID BOARD OF ESTIMATE ON THE 22ND DAY OF MAY 1941
DATED: NEW YORK, July 7 1941

Anna H. Clark
SECRETARY BOARD OF ESTIMATE

Stanley W. Kees
PRESIDENT BOROUGH OF MANHATTAN

J. J. Hammond
CHIEF ENGINEER

W. J. Quinn
COMMISSIONER OF BOROUGH WORKS

DRAWN BY: **Sánchez**
CHECKED BY: **Spruon**
William D. Moffatt
ACTING SECTION ENGINEER
J. C. Collyer
ENGINEER OF DESIGN