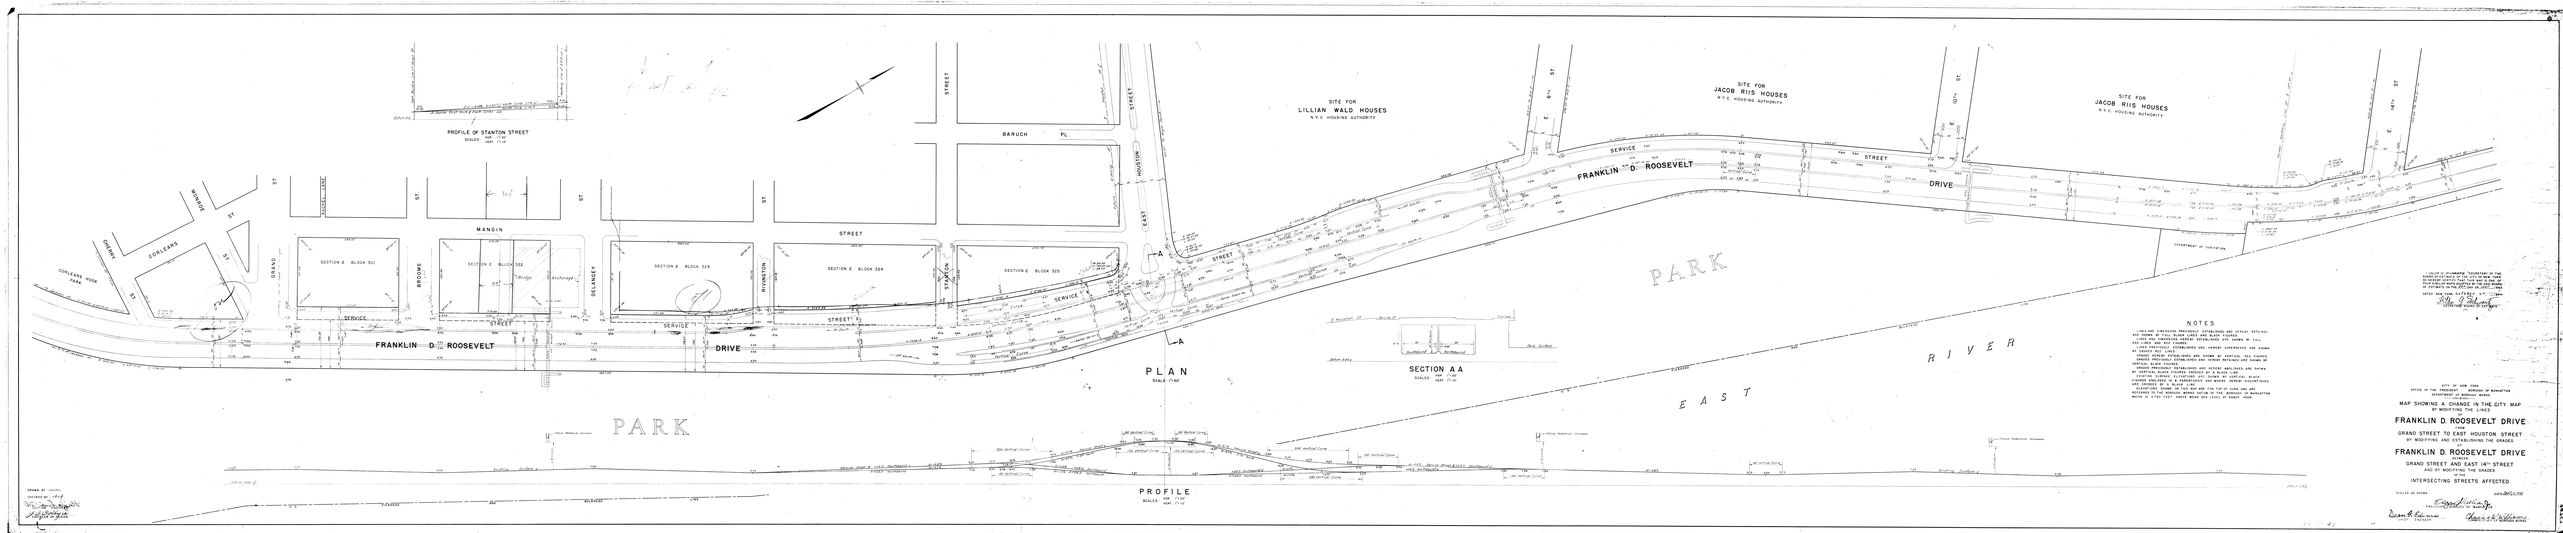
PROFILE OF STANTON STREET
SCALES: HORZ. 1"=10'
VERT. 1"=5'
SITE FOR
LILLIAN WALD HOUSES
N.Y.C. HOUSING AUTHORITY
SITE FOR
JACOB RIIS HOUSES
N.Y.C. HOUSING AUTHORITY
SITE FOR
JACOB RIIS HOUSES
N.Y.C. HOUSING AUTHORITY
BARUCH PL.
MANGIN
STREET
MONROE ST.
CORLEARS
CORLEARS HOOK PARK
CHERRY ST.
GRAND ST.
BROOME ST.
DELANCEY ST.
RIVINGTON ST.
STANTON ST.
EAST HOUSTON STREET
E. 6TH ST.
E. 10TH ST.
E. 14TH ST.
SECTION 2 BLOCK 321
SECTION 2 BLOCK 322
SECTION 2 BLOCK 323
SECTION 2 BLOCK 324
SECTION 2 BLOCK 325
Bridge
Anchorage
SERVICE
STREET
FRANKLIN D. ROOSEVELT
DRIVE
PARK
EAST
RIVER
DEPARTMENT OF SANITATION
PLAN
SCALE: 1"=50'
SECTION A A
SCALES: HORZ. 1"=10'
VERT. 1"=5'
PROFILE
SCALES: HORZ. 1"=50'
VERT. 1"=5'
NOTES
LINES AND DIMENSIONS PREVIOUSLY ESTABLISHED ARE VERTICAL RETAINING ARE SHOWN BY FULL BLACK LINES AND BLACK FIGURES
NEW LINES AND DIMENSIONS ARE SHOWN BY DASHED LINES AND BLACK FIGURES
LINES AND DIMENSIONS SUPERSEDED ARE HORIZONTAL SUPERSEDED ARE SHOWN BY DASHED RED LINES.
LINES AND DIMENSIONS PREVIOUSLY ARE SHOWN BY VERTICAL RED FIGURES
GRADES PREVIOUSLY ESTABLISHED ARE SHOWN RETAINED ARE SHOWN BY VERTICAL BLACK FIGURES
GRADES PREVIOUSLY ESTABLISHED ARE SUPERSEDED ARE SHOWN BY VERTICAL BLACK FIGURES ENCLOSED IN A RECTANGLE
GRADES NEW ARE SHOWN BY VERTICAL BLACK FIGURES ENCLOSED IN A PARENTHESIS
ELEVATIONS SHOWN ON PLAN AND ARE FOR TOP OF CURB AND ARE REFERRED TO THE BOROUGH WORKS DATUM OF THE BOROUGH OF MANHATTAN WHICH IS 2.750 FEET ABOVE MEAN SEA LEVEL AT SANDY HOOK.
CITY OF NEW YORK
OFFICE OF THE PRESIDENT — BOROUGH OF MANHATTAN
DEPARTMENT OF BOROUGH WORKS
MAP SHOWING A CHANGE IN THE CITY MAP
BY MODIFYING THE LINES
FRANKLIN D. ROOSEVELT DRIVE
FROM
GRAND STREET TO EAST HOUSTON STREET
BY MODIFYING AND ESTABLISHING THE GRADES
FRANKLIN D. ROOSEVELT DRIVE
FROM
GRAND STREET AND EAST 14TH STREET
AND BY MODIFYING THE GRADES
INTERSECTING STREETS AFFECTED
SCALES AS SHOWN
DATE DEC. 21, 1940
DRAWN BY
CHECKED BY
CHIEF ENGINEER
CHIEF ENGINEER
2574-A