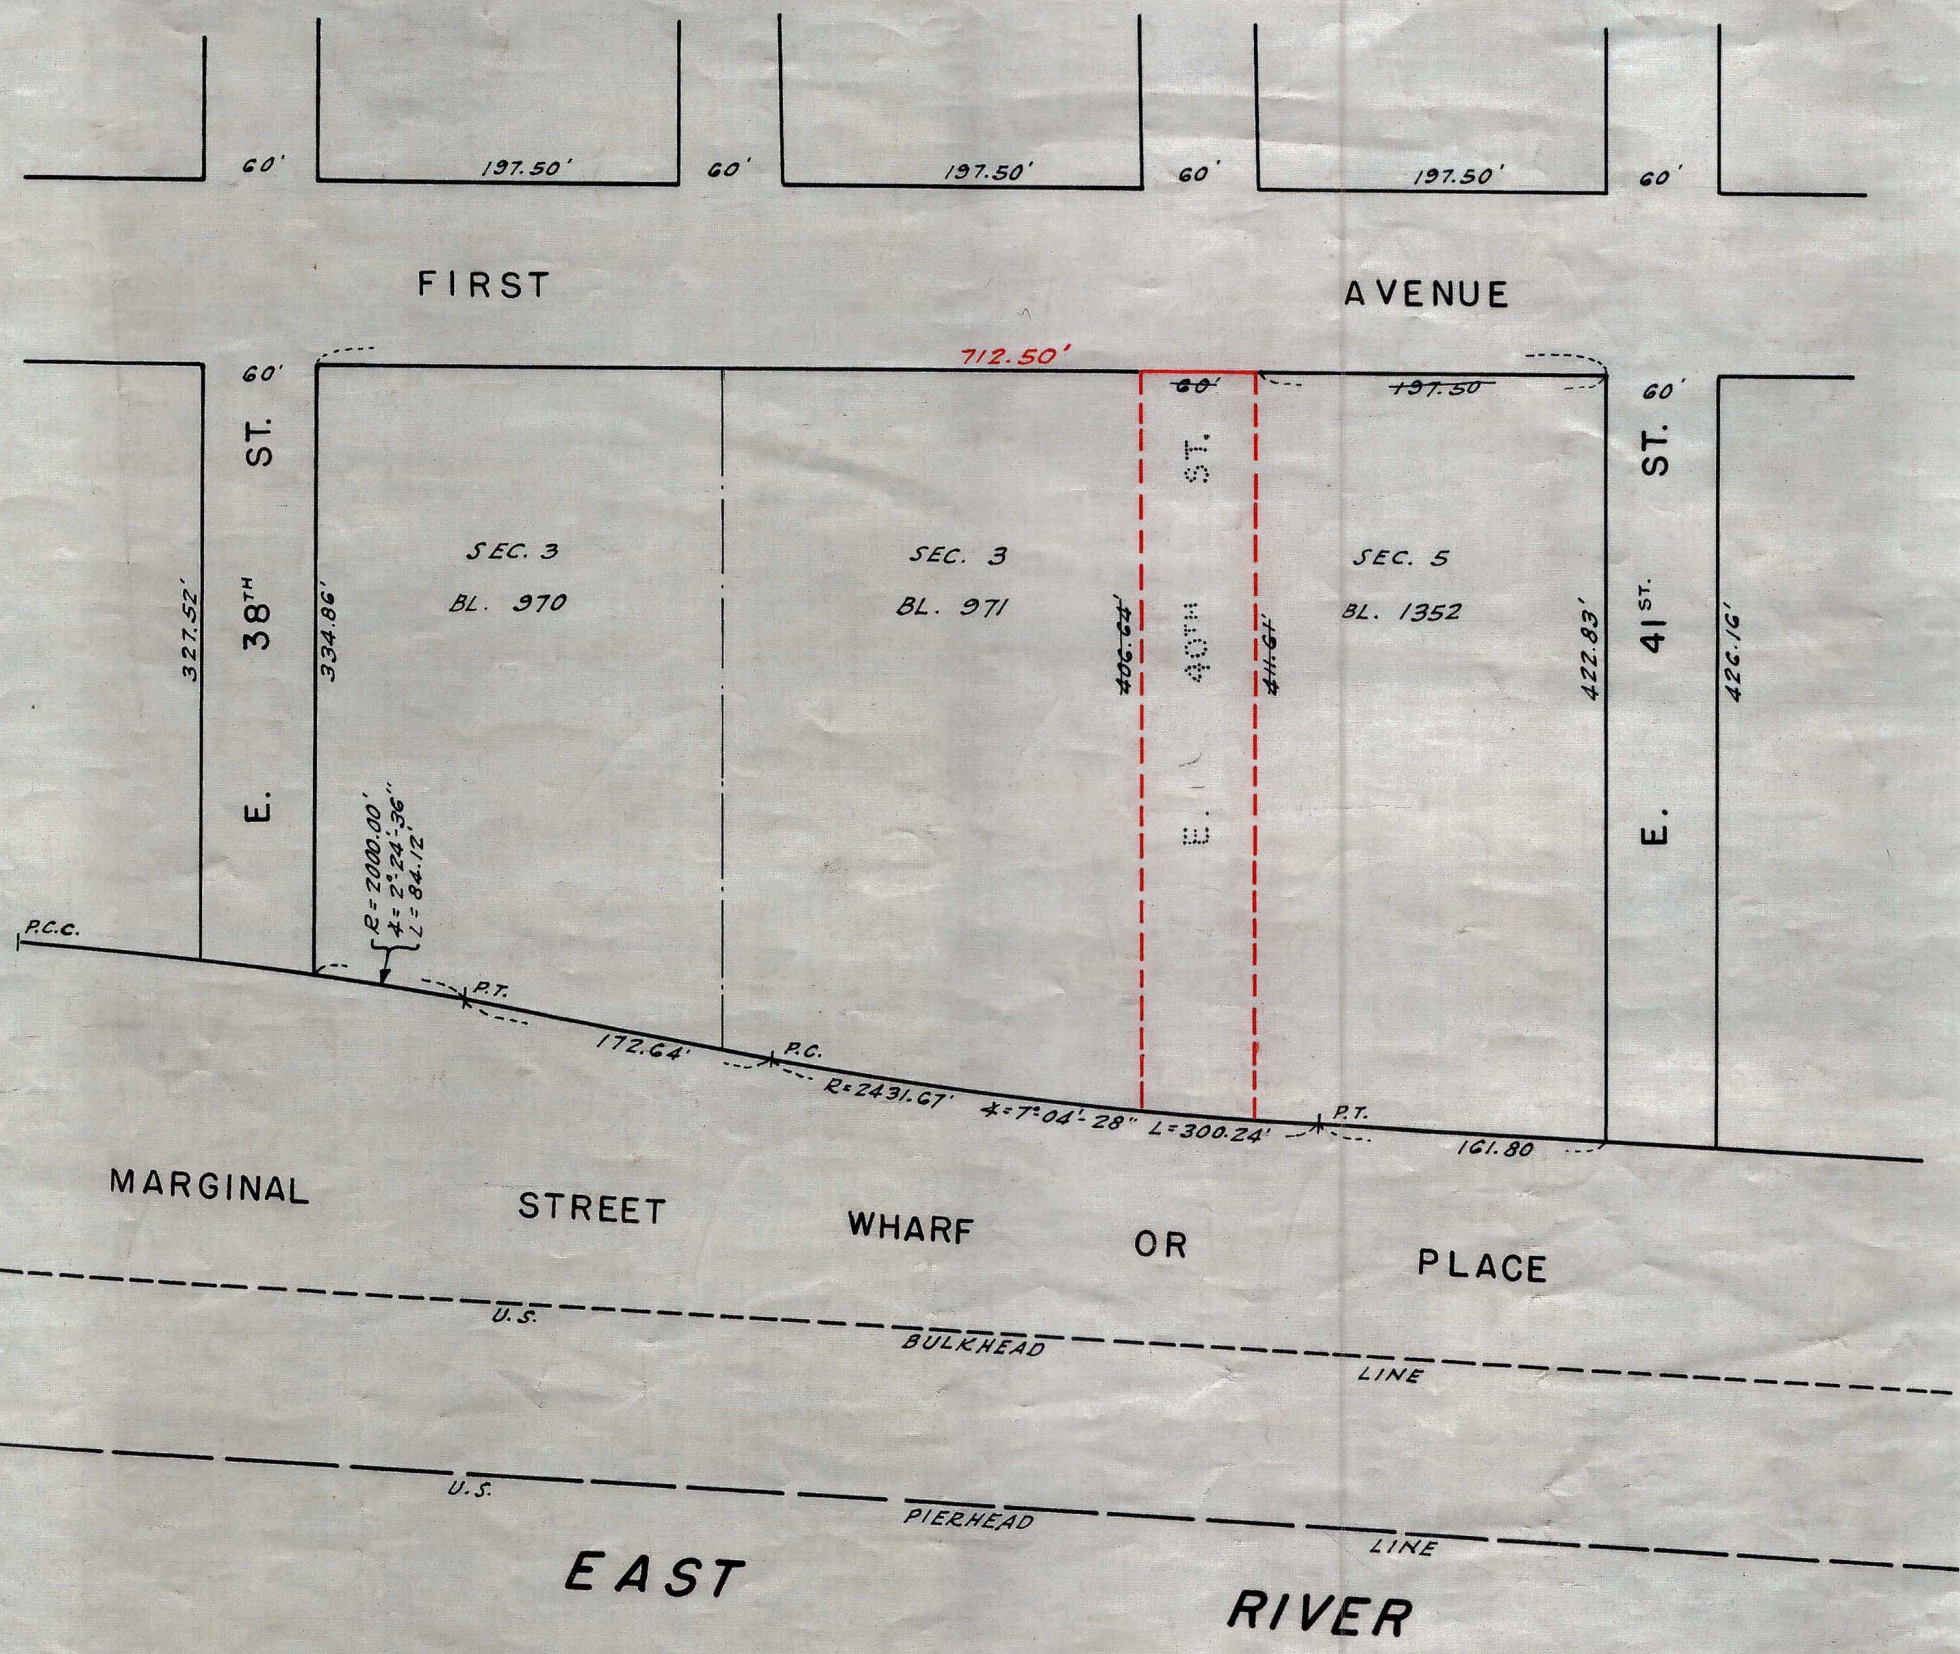

NOTES

Lines and Dimensions previously established and hereby retained are shown by Full Black Lines and Black Figures.

Lines and Dimensions hereby established are shown by full Red Lines and Red Figures.

Lines previously established and hereby eliminated are shown by Dashed Red Lines.

Dimensions previously established and hereby eliminated are shown by Black Figures crossed by a Black Line.

Drawn By: G.L.
Checked By: W.M.
William Hebbett
Section Engineer
J. C. Collyer
Engineer of Design

I, Hilda G. Schwartz, Secretary of the Board of Estimate of the City of New York do hereby certify that this Map is one of Five similar Maps adopted by the said Board of Estimate on the 7TH day of Dec. 1950

Dated: New York January 31, 1951

Hilda G. Schwartz
Secretary, Board of Estimate

CITY OF NEW YORK
OFFICE OF THE PRESIDENT BOROUGH OF MANHATTAN
DEPARTMENT OF BOROUGH WORKS

MAP SHOWING A CHANGE IN THE CITY MAP
BY ELIMINATING THE LINES OF

EAST 40TH STREET

BETWEEN MARGINAL STREET AND FIRST AVENUE

DATED: APRIL 28, 1949 SCALE: 1"=80'

Hugo Rogers
PRESIDENT BOROUGH OF MANHATTAN

Michael Kle
CHIEF ENGINEER

CHIEF ENGINEER OF DESIGN

Drawer 18

Ruled on the Copper at the Borough Bureau of Highways 2/5/51

B

29089