


PLAN
SCALE 1"=50'

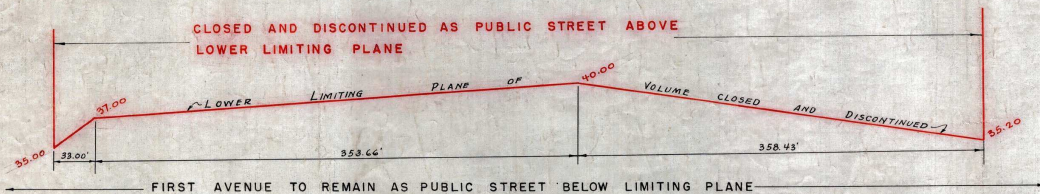

PROFILE


SCALES: HOR. 1" = 50'
VER. 1" = 5'

NOTES

THE VOLUME OF FIRST AVENUE CLOSED AND DISCONTINUED ABOVE A DESIGNATED LIMITING PLANE IS ENCLOSED BY FULL RED LINES AND RED FIGURES AND IS THE SURFACE AND UP-AIR RIGHTS TO BE DEEDED TO THE UNITED NATIONS FROM THE CITY OF NEW YORK. THE CITY OF NEW YORK IS TO RETAIN PERMANENT RIGHTS OF ACCESS TO THE SUBSTRUCTURES IN AND UNDER THE CLOSED AREA FOR MAINTENANCE AND REPAIRS.

ELEVATIONS DEFINING THE LOWER LIMITING PLANE OF THE VOLUME CLOSED AND DISCONTINUED ARE SHOWN BY VERTICAL RED FIGURES.

ELEVATIONS SHOWN ON THIS MAP ARE REFERRED TO THE BOROUGH WORKS DATUM OF THE BOROUGH OF MANHATTAN WHICH IS 2.75 FEET ABOVE MEAN SEA LEVEL AT SANDY HOOK.

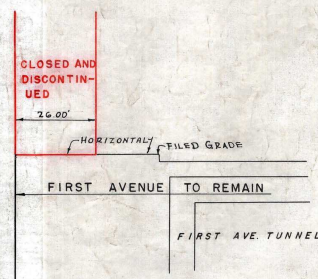

SECTION A-A

SCALES: HOR. 1" = 20'
VER. 1" = 5'

I, RUTH W. WHALEY, SECRETARY OF THE BOARD OF ESTIMATE OF THE CITY OF NEW YORK DO HEREBY CERTIFY THAT THIS MAP IS ONE OF FIVE SIMILAR MAPS ADOPTED BY THE SAID BOARD OF ESTIMATE ON THE 11TH DAY OF MARCH, 1954 (Cul. No. 1)

DATED: NEW YORK, JULY 1, 1954

Ruth W. Whaley
SECRETARY, BOARD OF ESTIMATE

CITY OF NEW YORK
OFFICE OF THE PRESIDENT, BOROUGH OF MANHATTAN
DEPARTMENT OF BOROUGH WORKS
MAP SHOWING A CHANGE IN THE STREET SYSTEM
BY CLOSING AND DISCONTINUING A VOLUME OF
FIRST AVENUE
BETWEEN EAST 42ND STREET AND EAST 45TH STREET
ABOVE A DESIGNATED LIMITING PLANE
PURSUANT TO CHAPTER 15, TITLE "E" OF THE
ADMINISTRATIVE CODE OF THE CITY OF NEW YORK
DATED: SEPT. 29, 1950
SCALES AS SHOWN

Robert T. Weaver
PRESIDENT, BOROUGH OF MANHATTAN

Anthony Bonomo
CHIEF ENGINEER

DRAWN BY *GAK*
CHECKED BY *WNT*

William J. ...
SECTION ENGINEER
S.O. ...
ENGINEER OF DESIGN

Drawn 39

Acc. No. 29299