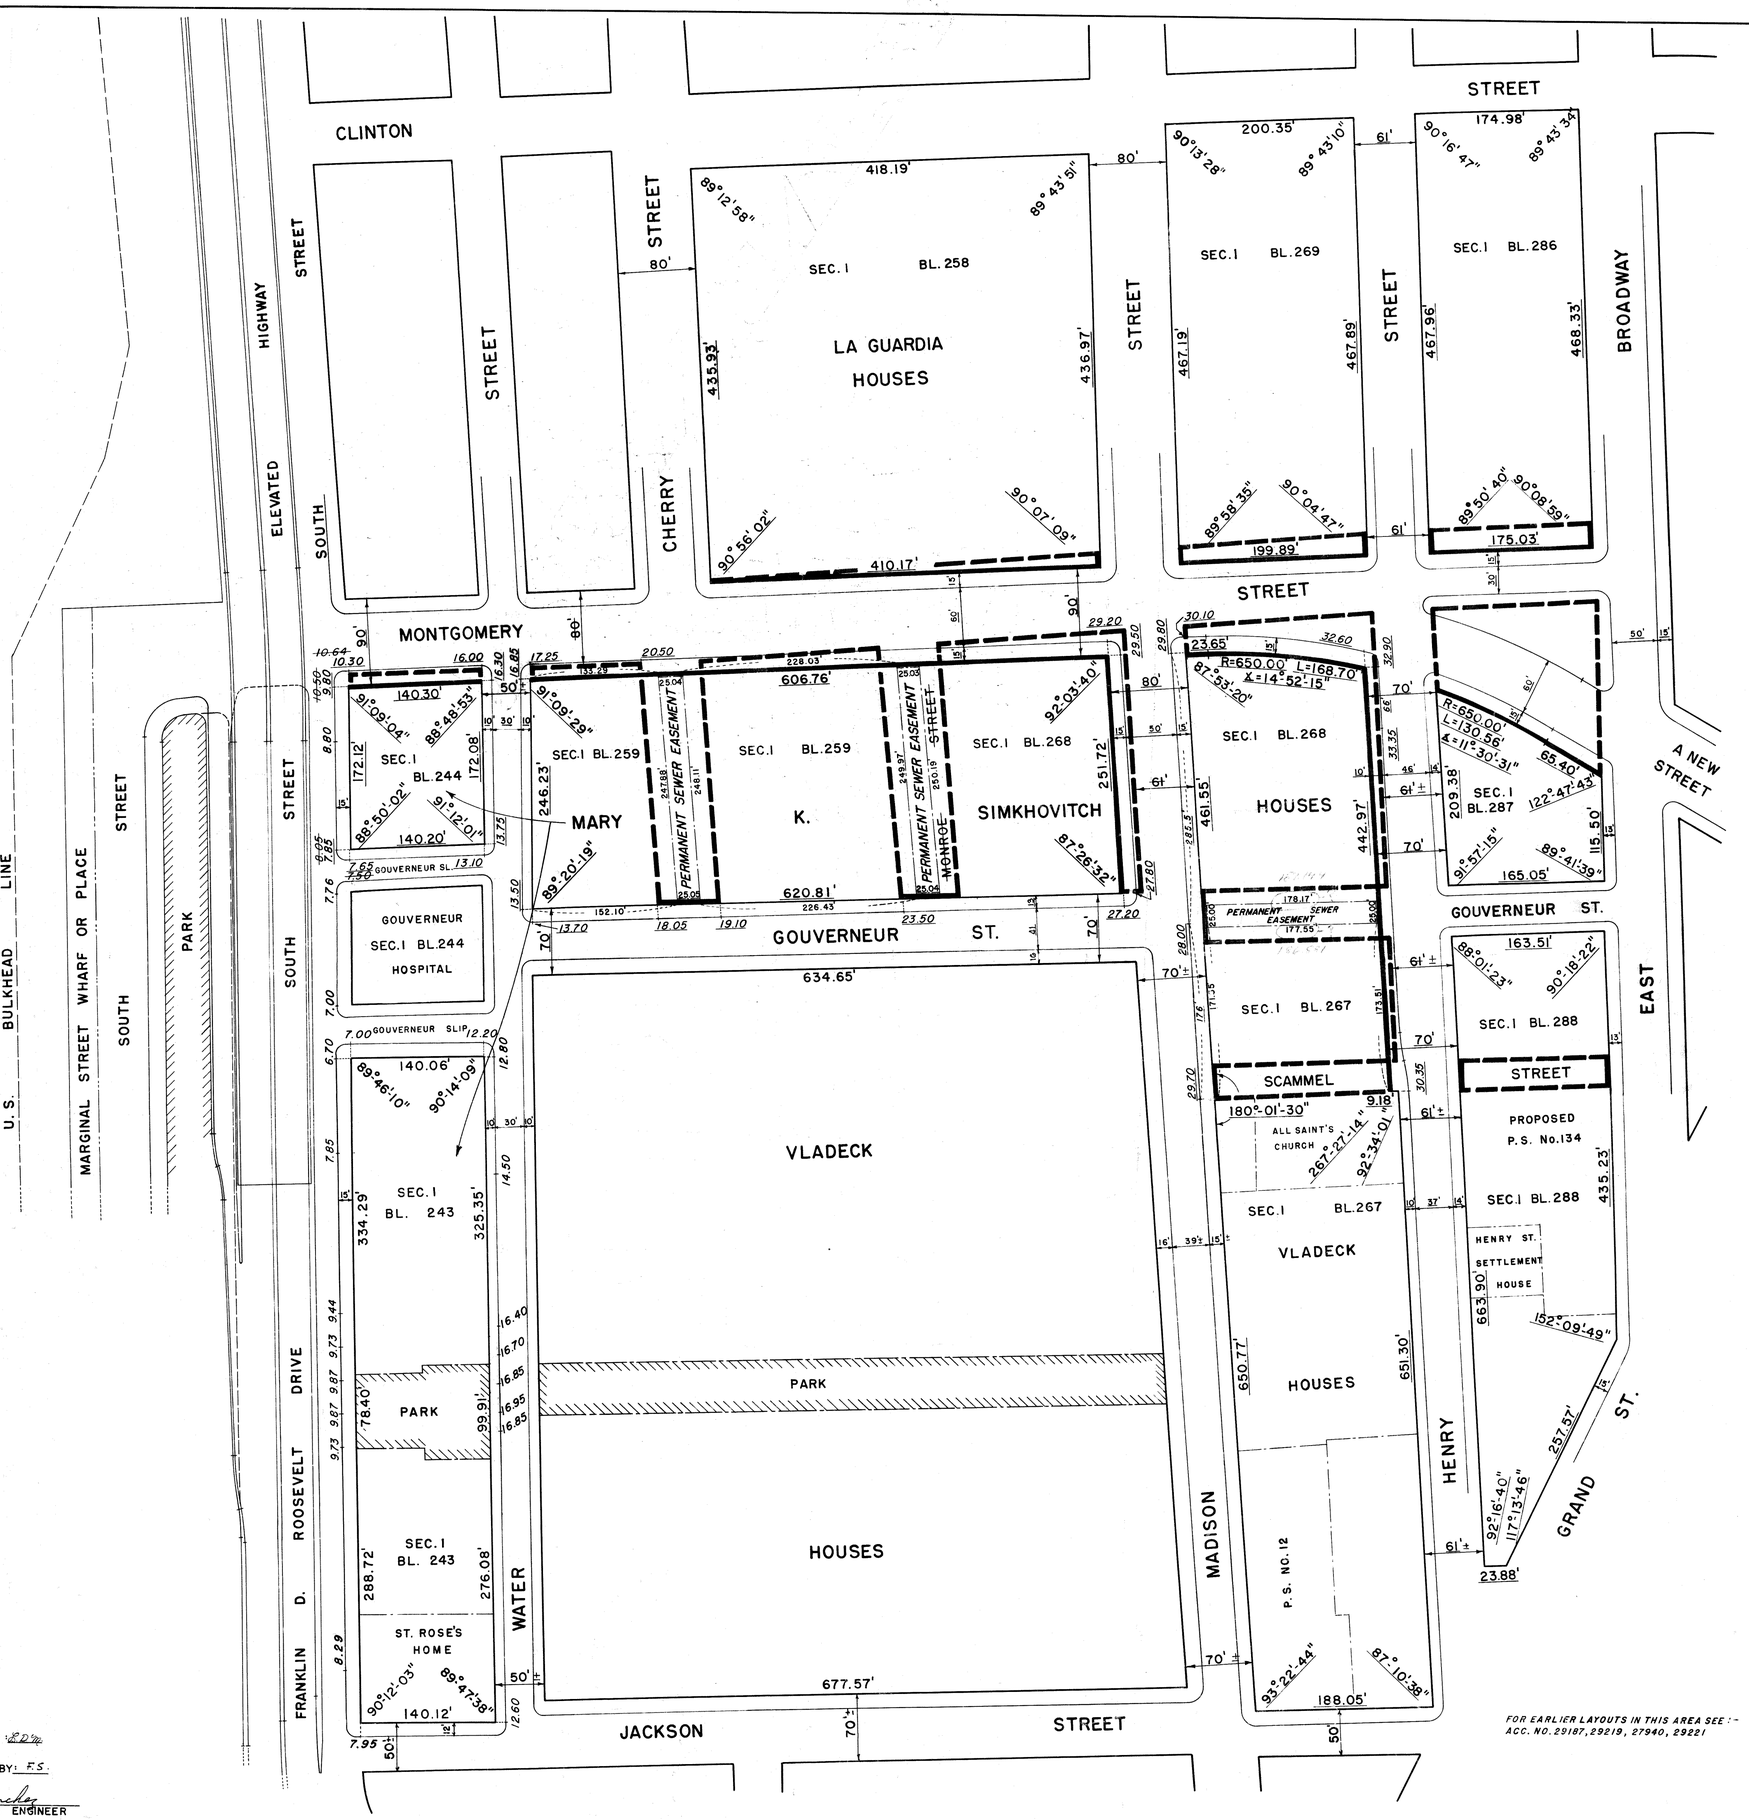

I, RUTH W. WHALEY, SECRETARY OF THE BOARD OF ESTIMATE OF THE CITY OF NEW YORK DO HEREBY CERTIFY THAT THIS MAP IS ONE OF FIVE SIMILAR MAPS ADOPTED BY THE SAID BOARD OF ESTIMATE ON THE 25 DAY OF MARCH 1959

DATED: NEW YORK MAY 4 1959

Ruth W. Whaley
SECRETARY BOARD OF ESTIMATE
H.F.

NOTES

———	INDICATES STREET LINE HERETOFORE ESTABLISHED AND HEREBY RETAINED.
▬▬▬	INDICATES STREET LINE HEREBY ESTABLISHED.
- - - -	INDICATES STREET LINE HERETOFORE ESTABLISHED AND HEREBY ELIMINATED.
634.65'	INDICATES DIMENSION HERETOFORE ESTABLISHED AND HEREBY RETAINED.
620.81'	INDICATES DIMENSION HEREBY ESTABLISHED.
~~61'~~	INDICATES DIMENSION HERETOFORE ESTABLISHED AND HEREBY ELIMINATED.
7.95'	INDICATES ELEVATION HERETOFORE ESTABLISHED AND HEREBY RETAINED.
16.00	INDICATES ELEVATION HEREBY ESTABLISHED.
~~10.64'~~	INDICATES ELEVATION HERETOFORE ESTABLISHED AND HEREBY ELIMINATED.
114'	INDICATES TIE-IN DISTANCES TO ELEVATIONS HEREBY ESTABLISHED.
———	INDICATES SIDEWALK AND ROADWAY TREATMENT HEREBY ESTABLISHED OR HERETOFORE ESTABLISHED AND RETAINED.
16'	INDICATES SIDEWALK AND ROADWAY TREATMENT DIMENSION HERETOFORE ESTABLISHED AND RETAINED.
15'	INDICATES SIDEWALK AND ROADWAY TREATMENT DIMENSION HEREBY ESTABLISHED.
	ELEVATIONS ARE FOR TOP OF CURB AND ARE REFERRED TO THE BOROUGH WORKS DATUM OF THE BOROUGH OF MANHATTAN WHICH IS 2.75 FEET ABOVE THE U.S.C.& G. DATUM AT SANDY HOOK.
PARK	INDICATES PARK HERETOFORE ESTABLISHED AND HEREBY RETAINED.

CITY OF NEW YORK
OFFICE OF THE PRESIDENT BOROUGH OF MANHATTAN
DEPARTMENT OF BOROUGH WORKS

MAP SHOWING A CHANGE IN THE STREET SYSTEM BY ELIMINATING AND WIDENING THE STREET LINES WITHIN THE AREA GENERALLY BOUNDED BY

SOUTH STREET, MONTGOMERY STREET, EAST BROADWAY, GRAND STREET, AND JACKSON STREET

AND BY ESTABLISHING GRADES THEREFOR IN CONNECTION WITH THE

MARY K. SIMKHOVITCH HOUSES

DATED: NOV. 6, 1958 SCALE: 1" = 80'

FOR EARLIER LAYOUTS IN THIS AREA SEE:- ACC. NO. 29187, 29219, 27940, 29221

PRESIDENT BOROUGH OF MANHATTAN

DRAWN BY: R.D.P.
CHECKED BY: F.S.
SECTION ENGINEER
ENGINEER OF PLANNING
ENGINEER OF DESIGN

Anthony Romano
CHIEF ENGINEER

FILED IN THE OFFICE OF THE PRES. BORO. MAN. MAY 5TH 1959 G. KATZ

29578
29578
29578

Drawer 40