CONTRACT SHEET OF

SECTION A-A
1" = 5'-0"
WILLIAMSBURG BRIDGE ANCHORAGE

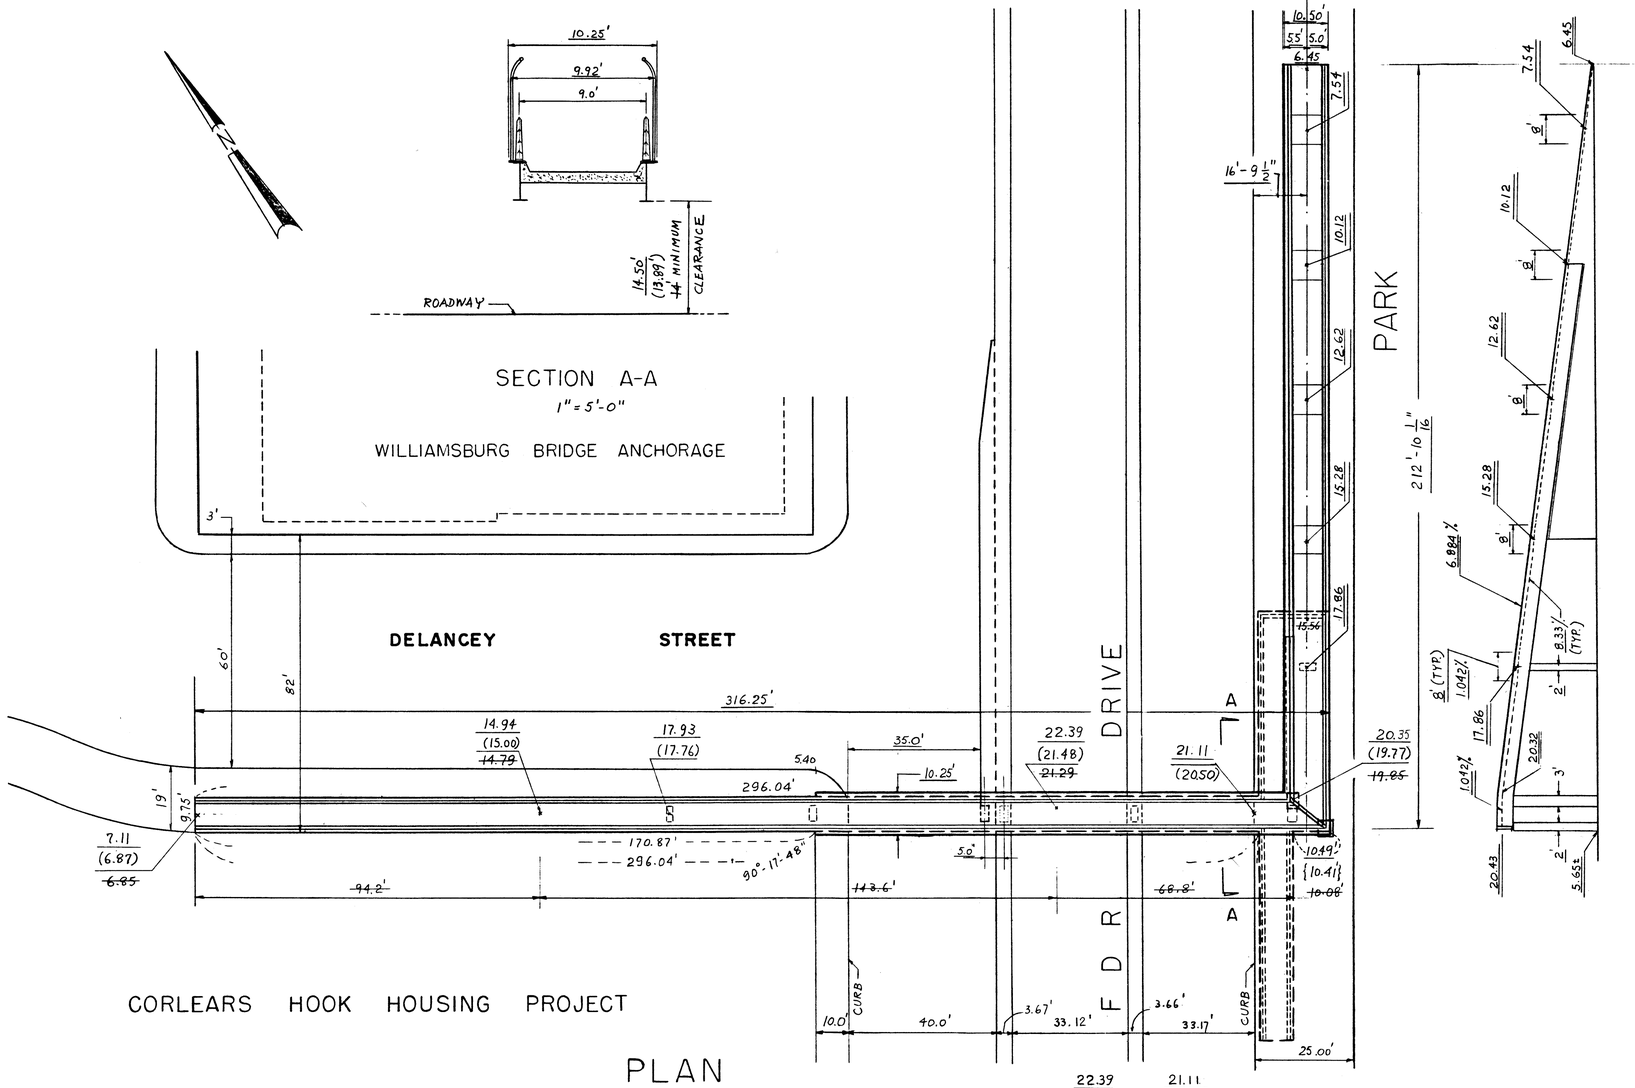

EAST RAMP - PROFILE
HOR. 1" = 20'
SCALES :
VER. 1" = 10'

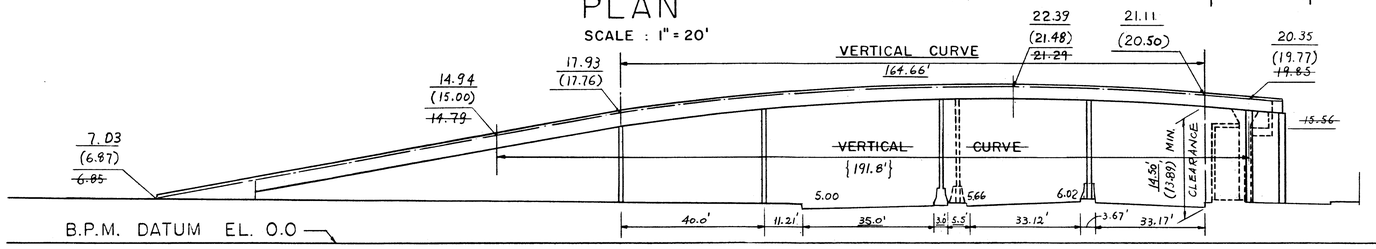

PLAN
SCALE : 1" = 20'

PROFILE (LOOKING NORTH)

SCALES : HOR. 1" = 20'
VER. 1" = 10'

NOTE:

22.16 INDICATES ELEVATION HEREBY ESTABLISHED

(21.48) INDICATES EXISTING ELEVATION

~~21.29~~ INDICATES ELEVATION HERETOFORE ESTABLISHED AND HEREBY ELIMINATED

10.49' INDICATES DIMENSION HEREBY ESTABLISHED

{10.41'} INDICATES EXISTING DIMENSION

~~10.06'~~ INDICATES DIMENSION HERETOFORE ESTABLISHED AND HEREBY ELIMINATED

9.75' INDICATES DIMENSION HERETOFORE ESTABLISHED AND HEREBY RETAINED

——— INDICATES LINES HEREBY ESTABLISHED

——— INDICATES LINES HERETOFORE ESTABLISHED AND HEREBY RETAINED

- - - - INDICATES LINES HERETOFORE ESTABLISHED AND HEREBY ELIMINATED

I, THEODORE MEEKINS, SECRETARY OF THE BOARD OF ESTIMATE OF THE CITY OF NEW YORK DO HEREBY CERTIFY THAT THIS MAP IS ONE OF SEVEN SIMILAR MAPS ADOPTED BY THE SAID BOARD OF ESTIMATE ON THE July 18, 1985 CAL. 10

DATED : NEW YORK 3/28/88

Theodore Meekins
SECRETARY, BOARD OF ESTIMATE

CITY OF NEW YORK
OFFICE OF THE PRESIDENT BOROUGH OF MANHATTAN
TOPOGRAPHICAL BUREAU

MAP SHOWING A CHANGE IN THE CITY MAP
BY
MODIFYING THE LINES AND GRADES
OF

A PEDESTRIAN BRIDGE

OVER

FRANKLIN D. ROOSEVELT DRIVE AT THE FOOT OF DELANCEY STREET

DATED : DEC. 13, 1984

SCALE : AS NOTED

PRESIDENT, BOROUGH OF MANHATTAN

Anthony C. Gubitta P.E.
DIRECTOR, TOPOGRAPHICAL BUREAU

CORLEARS HOOK HOUSING PROJECT

GROUP LEADER
ASST SECTION CHIEF
SECTION CHIEF

DRAWN BY A.S.
DESIGNED BY
CHECKED BY

D.P. 1000-H-4

DRAWER #40

Filed in the office of the Borough President Manhattan 4/7/88 Harry J. Kleidman

ACC. NO. 30105