CITY OF NEW YORK, BOROUGH OF MANHATTAN
OFFICE OF THE PRESIDENT
TOPOGRAPHICAL BUREAU

ACC NO. 30201

MAP SHOWING A CHANGE IN THE CITY MAP
BY LAYING OUT
THE EXTENSION
OF
EDGECOMBE AVENUE
AND
JUMEL PLACE
BETWEEN W. 169TH STREET AND W. 171ST STREET
AND
ELIMINATING, DISCONTINUING AND CLOSING
A NEW STREET
BETWEEN
JUMEL PLACE AND EDGECOMBE AVENUE
AND
ESTABLISHING GRADES AND ROADWAY TREATMENT
ALL IN CONNECTION WITH THE SITE
FOR THE 33RD PRECINCT STATION HOUSE

DATED: December 17, 1999

Anthony C. Gulotta
ANTHONY C. GULOTTA, P.E.
CONSULTING ENGINEER
BOROUGH OF MANHATTAN

SCALE: 1"=60'

C. VIRGINIA FIELDS
PRESIDENT
BOROUGH OF MANHATTAN

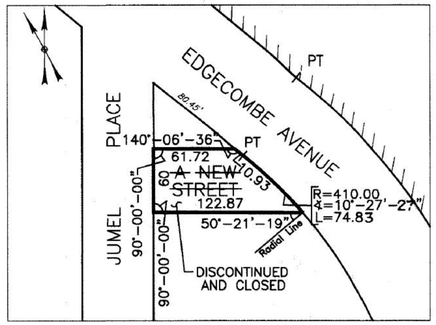

PLAN SHOWING THE DISCONTINUING AND CLOSING OF A NEW STREET BETWEEN JUMEL PLACE AND EDGECOMBE AVENUE

LEGEND:

———	Indicates street line heretofore established and hereby retained.
———	Indicates street line hereby established.
— — —	Indicates street line heretofore established and hereby eliminated.
———	Indicates sidewalk and roadway treatment hereby established or heretofore established and hereby retained.
80.00	Indicates dimension heretofore established and hereby retained.
80.00	Indicates dimension hereby established.
~~80.00~~	Indicates dimension heretofore established and hereby eliminated.
49.00	Indicates elevation heretofore established and hereby retained.
49.00 P	Indicates pavement elevation heretofore established.
49.00	Indicates elevation hereby established.
~~49.00~~	Indicates elevation heretofore established and hereby eliminated.
70'	Indicates roadway and sidewalk treatment dimension hereby established.
15'	Indicates sidewalk and roadway treatment dimension heretofore established and hereby retained.
70'	Indicates tie–in distances to elevations heretofore established and hereby retained.
70'	Indicates tie–in distance to an elevation hereby established or a new tie–in distance to an elevation heretofore established.
~~70'~~	Indicates a superseded tie–in distance or a tie–in distance to an elevation heretofore established and hereby eliminated.
PARK	Indicates Park heretofore established and hereby retained.
DISCONTINUED AND CLOSED	Indicates street lands to be discontinued and closed.

ELEVATIONS ARE FOR TOP OF CURB UNLESS OTHERWISE NOTED AND ARE REFERRED TO THE DATUM OF THE TOPOGRAPHICAL BUREAU, OFFICE OF THE PRESIDENT, BOROUGH OF MANHATTAN, WHICH IS 2.75 FEET ABOVE THE UNITED STATES COAST & GEODETIC SURVEY DATUM MEAN SEA LEVEL, SANDY HOOK, NEW JERSEY.

I, Rosa R. Romero, Secretary of the City Planning Commission, do hereby certify that this map is one of eight similar maps approved by the City Planning Commission on the 28th day of June, 2000 (Cal. No. 16), which action comprised final approval, and that these maps were filed on the date of this certification and will become effective on the following day.

Date: New York June 7 2002

Rosa R. Romero
Secretary, City Planning Commission

SCALE: 60 FEET TO 1 INCH
0' 60' 120' 180' 240'

METRIC SCALE : 1 : 720 (1 cm = 7.2 M)
0 1 2 3 4 5 6 7 8 9 10 cm
0 10 20 30 40 50 60 70 M

REFERENCE MAPS:
ACC. NO. 30032, DATED OCT. 12, 1973
ACC. NO. 23288, DATED OCT. 17, 1917
ACC. NO. 8509, DATED FEB. 15, 1911
ACC. NO. 7384, DATED NOV. 11, 1904
ACC. NO. 5313, DATED FEB. 2, 1894
ACC. NO. 4007, DATED AUG. 5, 1885

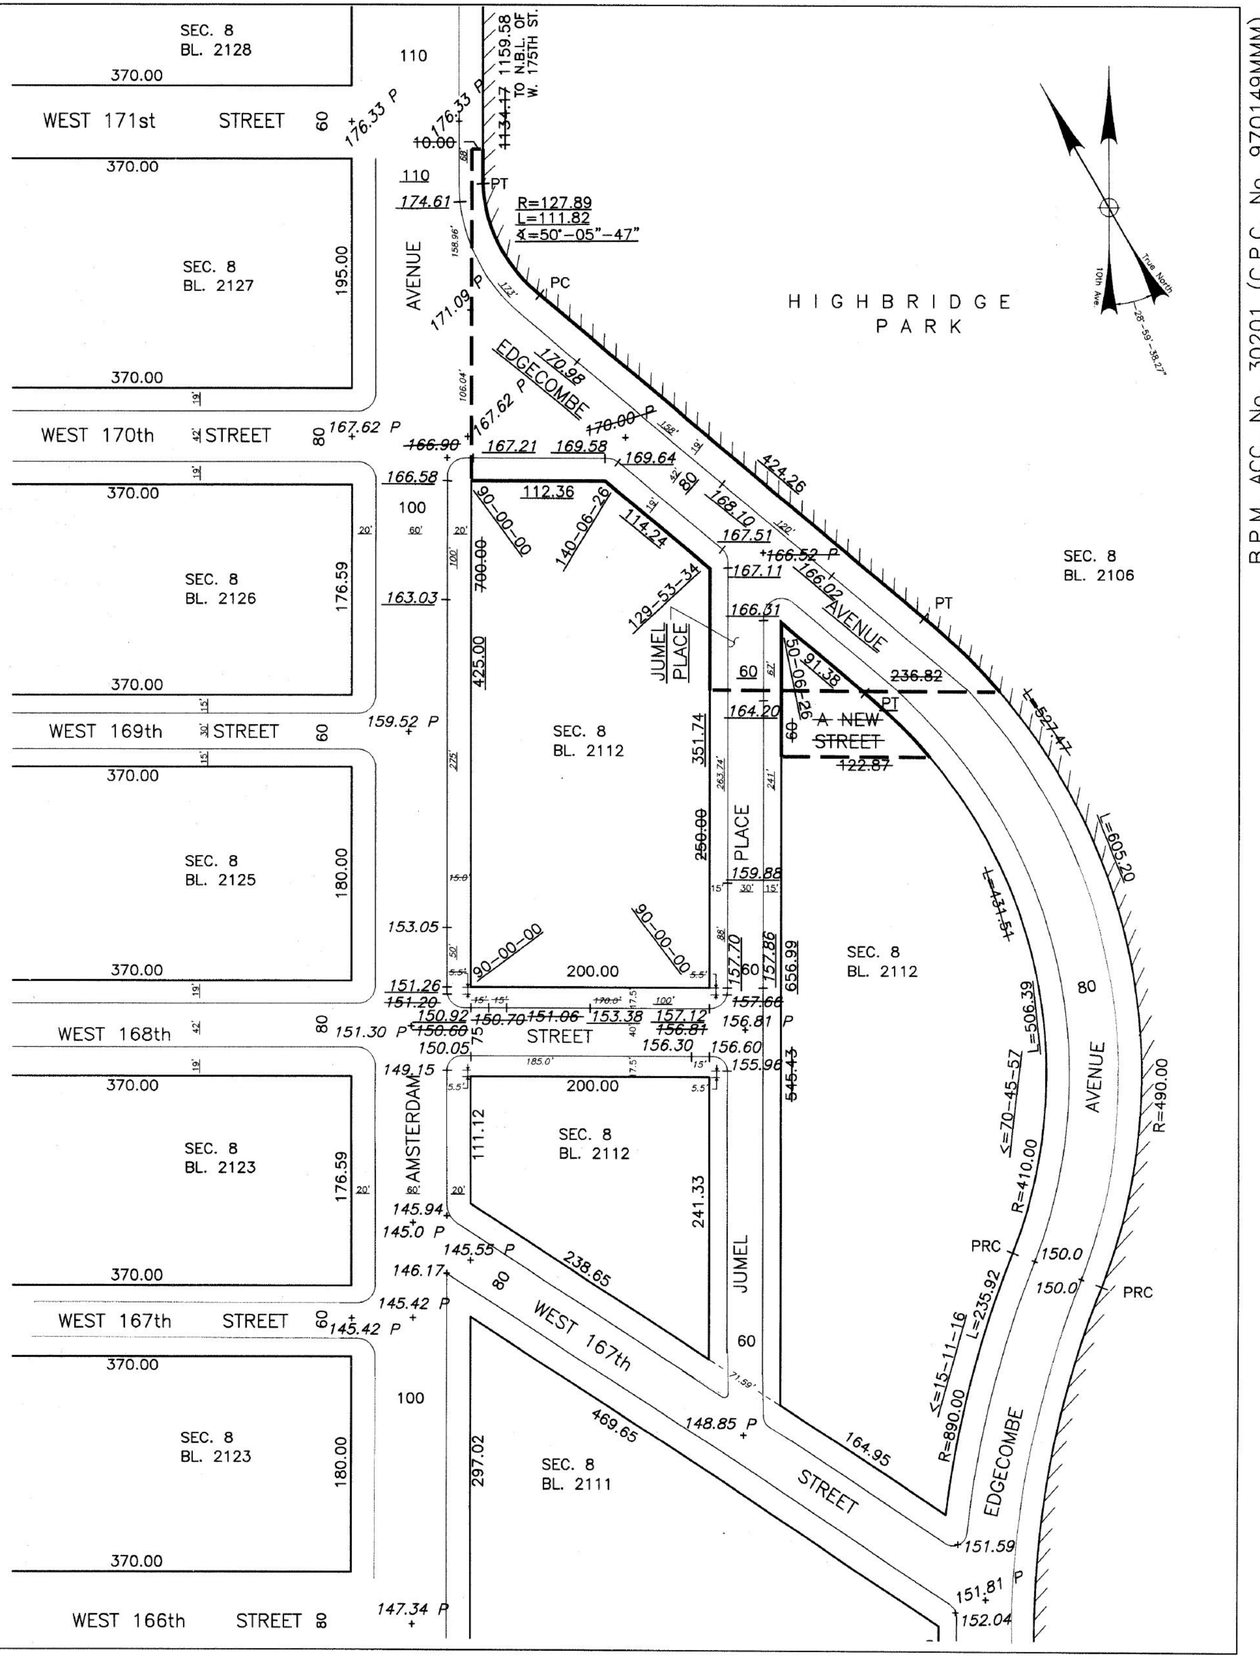

B.P.M. ACC. No. 30201 (a) (C.P.C. No. 970149MMM)